

# **EXHIBIT 7**

<b>AMENDMENT OF SOLICITATION/MODIFICATION OF CONTRACT</b>		1. CONTRACT ID CODE		PAGE OF PAGES 1   2	
2. AMENDMENT/MODIFICATION NO. A00001		3. EFFECTIVE DATE SEE BLOCK 16C		4. REQUISITION/PURCHASE REQ. NO. W45XMA91224061	
5. PROJECT NO. (If Applicable)		6. ISSUED BY Albuquerque District		7. ADMINISTERED BY Albuquerque District	
8. NAME AND ADDRESS OF CONTRACTOR (No., Street, County, State, and Zip Code) Koman Construction, LLC 2700 Gambell St Ste. 401 Anchorage AK 99503 USA		9A. AMENDMENT OF SOLICITATION NO.		9B. DATED (SEE ITEM 11)	
CODE		FACILITY CODE		10A. MODIFICATION OF CONTRACT/ORDER W9126G19C0025 NA	
				10B. DATED (SEE ITEM 13) 06 May 2019	

**11. THIS ITEM APPLIES ONLY TO AMENDMENTS OF SOLICITATIONS**

- ☐ The above numbered solicitation is amended as set forth in Item 14. The hour and date specified for receipt of Offers ☐ is extended, ☐ is not extended
- Offers must acknowledge receipt of this amendment prior to the hour and date specified in the solicitation or as amended, by one of the following methods:  
 (a) By completing items 8 and 15, and returning \_\_\_\_\_ copies of the amendment; (b) By acknowledging receipt of this amendment on each copy of the offer submitted; or (c) By separate letter or telegram which includes a reference to the solicitations and amendment numbers. **FAILURE OF YOUR ACKNOWLEDGEMENT TO BE RECEIVED AT THE PLACE DESIGNATED FOR THE RECEIPT OF OFFERS PRIOR TO THE HOUR AND DATE SPECIFIED MAY RESULT IN REJECTION OF YOUR OFFER.** If by virtue of this amendment you desire to change an offer already submitted, such change may be made by telegram or letter, provided each telegram or letter makes reference to the solicitation and this amendment, and is received prior to the opening hour and date specified.

**12. ACCOUNTING AND APPROPRIATION DATA**

Contract Amount Unchanged

**13. THIS ITEM APPLIES ONLY TO MODIFICATIONS OF CONTRACTS/ORDERS  
 IT MODIFIES THE CONTRACT/ORDER NO. AS DESCRIBED IN ITEM 14.**

	A. THIS CHANGE ORDER IS ISSUED PURSUANT TO: (Specify Authority)	THE CHANGES SET FORTH IN ITEM 14 ARE MADE IN THE CONTRACT ORDER NO. IN ITEM 10A.
	B. THE ABOVE NUMBERED CONTRACT/ORDER IS MODIFIED TO REFLECT THE ADMINISTRATIVE CHANGES (Such as changes in paying office appropriation date, etc) SET FORTH IN ITEM 14, PURSUANT TO THE AUTHORITY OF FAR 43.103(B).	
X	C. THIS SUPPLEMENTAL AGREEMENT IS ENTERED INTO PURSUANT TO AUTHORITY OF: FAR 52.243-4 CHANGES	
	D. OTHER	

E. IMPORTANT: Contractor ☐ is not, ☒ is required to sign this document and return original and \_\_\_\_\_ 1 copies to the issuing office.


**14. DESCRIPTION OF AMENDMENT/MODIFICATION (Organized by UCF section headings, including solicitation/contract subject matter where feasible.)**

Contract for El Paso Modular CPC.

Reference No. R00001  
 00001 Changes to Bldg. & Site

See Page 2.

Except as provided herein, all terms and conditions of the document referenced in Item 9A or 10A, as heretofore changed, remains unchanged and in full force and effect.

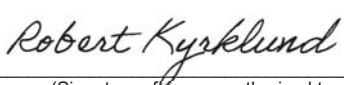15A. NAME AND TITLE OF SIGNER (Type or print) Robert Kyrklund - Executive Program Manager		16A. NAME AND TITLE OF CONTRACTING OFFICER (Type or print) Administrative Contracting Officer	
15B. CONTRACTOR/OFFEROR  (Signature of person authorized to sign)	15C. DATE SIGNED 5/18/2019	16B. UNITED STATES OF AMERICA PROVENCIO.GUILL ERMO.1217880048 BY _____ (Signature of Contracting Officer)	16C. DATE SIGNED 22 May 2019

MODIFICATION OF CONTRACT		DATE SIGNED	PAGE OF PAGES	
			2	2
Contract No:	W9126G19C0025 NA			
Modification No:	A00001			
Contractor:	Koman Construction, LLC			
Contract Title:	El Paso Modular CPC			
Location:				

**A. SCOPE OF WORK****00001 Changes to Bldg. & Site**

Refer to file 19C0025\_0001\_SKT\_115May19.pdf and provide design, supervision, labor, material, and equipment for reductions and additions as marked up in the file.  
A listing of reductions and additions (not all inclusive) associated with referenced file as follows:

## Reductions:

Water heaters, toilets, lavatories, janitor sinks, PEX hot water supply lines from water heaters, PEX cold water supply to water heaters, 30 AMP breakers to water heaters, electrical wiring to water heaters, partition walls, elimination of janitor's closets, and elimination of doors.

## Additions:

Electrical pedestal, service panel 400 AMP, terminations/connectors, rigid conduit installed underground (UG), 2 inch water line PVC, hose bib, 4 inch waste lines, and 2 ft. x 2 ft. hand boxes.

**B. CHANGE IN CONTRACT DRAWINGS****00001 Changes to Bldg. & Site**

Drawing SKT\_1\_15May19 The attached Sketch "19C0025\_0001\_SKT\_15May19.pdf", dated; 15 May 2019, provide in part for the changes in this modification and are made a part hereof.

**C. CHANGE IN CONTRACT SPECIFICATIONS****00001 Changes to Bldg. & Site**

Material and/or equipment represented by this Modification will be formally submitted for approval in accordance with the appropriate Specification Section and will be added to the approved Submittal Register.

**D. CHANGE IN CONTRACT PRICE**

Total contract price is unchanged.

**E. CHANGE IN CONTRACT TIME**

The contract completion date shall remain unchanged by this modification.

**F. CLOSING STATEMENT**

It is understood and agreed that pursuant to the above, the contract time is not affected, and the contract price remains unchanged, which reflects all credits due the Government and all debits due the Contractor. It is further understood and agreed that this adjustment constitutes compensation in full on behalf of the Contractor and its Subcontractors and Suppliers for all costs and markups directly or indirectly attributable for the change ordered, for all delays related thereto, for all extended overhead costs, and for performance of the change within the time frame stated.

<b>TRANSMITTAL OF SHOP DRAWINGS, EQUIPMENT DATA, MATERIAL SAMPLES, OR MANUFACTURER'S CERTIFICATES OF COMPLIANCE</b> For use of this form, see ER 415-1-10; the proponent agency is CECW-CE.				DATE 2019-05-08		TRANSMITTAL NO. 03		
<b>SECTION I - REQUEST FOR APPROVAL OF THE FOLLOWING ITEMS (This section will be initiated by the contractor)</b>								
TO: U.S. Army Engineer District, Fort Worth ATTN: CESWF-CT 819 Taylor Street, Room 2A17 Fort Worth, TX 76102-0300		FROM: KOMAN Construction, LLC 1490 S. Price Rd. Suite 204 Chandler, AZ 85286		CONTRACT NO. W9126G19C0025		CHECK ONE: <input checked="" type="checkbox"/> THIS IS A NEW TRANSMITTAL <input type="checkbox"/> THIS IS A RESUBMITTAL OF TRANSMITTAL _____		
SPECIFICATION SEC. NO. (Cover only one section with each transmittal)		PROJECT TITLE AND LOCATION El Paso Modular CPC, El Paso, Texas		THIS TRANSMITTAL IS FOR: (Check one) <input type="checkbox"/> FIO <input checked="" type="checkbox"/> GA <input type="checkbox"/> DA <input type="checkbox"/> CR <input type="checkbox"/> DA/CR <input type="checkbox"/> DA/GA				
ITEM NO. (See Note 3)	DESCRIPTION OF SUBMITTAL ITEM (Type size, model number/etc.)	SUBMITTAL TYPE CODE (See Note 8)	NO. OF COPIES	CONTRACT DOCUMENT REFERENCE		CONTRACTOR REVIEW CODE	VARIATION Enter "y" if requesting a variation (See Note 6)	USACE ACTION CODE (Note 9)
				SPEC. PARA. NO.	DRAWING SHEET NO.			
a.	b.	c.	d.	e.	f.	g.	h.	i.
1	Civil, site, Life safety, Architectural Permit Drawings	SD-02	1			A		
REMARKS Cc:								
I certify that the above submitted items had been reviewed in detail and are correct and in strict conformance with the contract drawings and specifications except as otherwise stated.								
KOMAN Construction, LLC				NAME OF CONTRACTOR		SIGNATURE OF CONTRACTOR <i>Robert Kyskelund</i>		
<b>SECTION II - APPROVAL ACTION</b>								
ENCLOSURES RETURNED (List by item No.)			NAME AND TITLE OF APPROVING AUTHORITY			SIGNATURE OF APPROVING AUTHORITY		DATE



## INSTRUCTIONS

1. Section I will be initiated by the Contractor in the required number of copies.
2. Each Transmittal shall be numbered consecutively. The Transmittal Number typically includes two parts separated by a dash (-). The first part is the specification section number. The second part is a sequential number for the submittals under that spec section. If the Transmittal is a resubmittal, then add a decimal point to the end of the original Transmittal Number and begin numbering the resubmittal packages sequentially after the decimal.
3. The "Item No." for each entry on this form will be the same "Item No." as indicated on ENG FORM 4288-R.
4. Submittals requiring expeditious handling will be submitted on a separate ENG Form 4025-R.
5. Items transmitted on each transmittal form will be from the same specification section. Do not combine submittal information from different specification sections in a single transmittal.
6. If the data submitted are intentionally in variance with the contract requirements, indicate a variation in column h, and enter a statement in the Remarks block describing the detailed reason for the variation.
7. ENG Form 4025-R is self-transmitting - a letter of transmittal is not required.
8. When submittal items are transmitted, indicate the "Submittal Type" (*SD-01 through SD-11*) in column c of Section I.  
Submittal types are the following:  

SD-01 - Preconstruction	SD-02 - Shop Drawings	SD-03 - Product Data	SD-04 - Samples	SD-05 - Design Data	SD-06 - Test Reports
SD-07 - Certificates	SD-08 - Manufacturer's Instructions	SD-09 - Manufacturer's Field Reports	SD-10 - O&M Data	SD-11 - Closeout	
9. For each submittal item, the Contractor will assign Submittal Action Codes in column g of Section I. The U.S. Army Corps of Engineers approving authority will assign Submittal Action Codes in column i of Section I. The Submittal Action Codes are:  

A -- Approved as submitted.	F -- Receipt acknowledged.
B -- Approved, except as noted on drawings. Resubmission not required.	X -- Receipt acknowledged, does not comply with contract requirements, as noted.
C -- Approved, except as noted on drawings. Refer to attached comments.	G -- Other action required ( <i>Specify</i> )
Resubmission required.	K -- Government concurs with intermediate design. ( <i>For D-B contracts</i> )
D -- Will be returned by separate correspondence.	R -- Design submittal is acceptable for release for construction. ( <i>For D-B contracts</i> )
E -- Disapproved. Refer to attached comments.	
10. Approval of items does not relieve the contractor from complying with all the requirements of the contract.







REVISIONS
DATE
DESCRIPTION

PROJECT: SECURITY-CENTRALIZED PROCESSING CENTER-EL PASO, TEXAS	PROJECT NO: W326519R0097
ISSUE DATE: 5-7-2019	REVIEW: ISSUED FOR PERMIT
DESIGNED BY: [Signature]	CHECKED BY: [Signature]
APPROVED BY: [Signature]	DATE: 5-7-2019
PLOT SCALE: REFER TO DRAWING	


**KOMAN CONSTRUCTION**  
1115 WEST 43RD STREET  
SUITE 100  
EL PASO, TEXAS 79907  
PHONE: 915.762.1800  
FAX: 915.762.1801  
WWW.KOMANCONSTRUCTION.COM

**PINNACLE**  
1115 WEST 43RD STREET  
SUITE 100  
EL PASO, TEXAS 79907  
PHONE: 915.762.1800  
FAX: 915.762.1801  
WWW.PINNACLECONSTRUCTION.COM

FY19 DEPARTMENT OF HOMELAND SECURITY-CENTRALIZED PROCESSING CENTER-EL PASO, TEXAS  
SOLICITATION NO. W326519R0097

SHEET NO	C-002
SHEET 3 OF 29	

**LEGAL DESCRIPTION**  
BEING THAT CERTAIN PARCELS OF LAND SITUATED WITHIN THE EASTERN RANGE OF THE FORT BLISS MILITARY RESERVATION WITHIN SECTION 3, BLOCK 81, TOWNSHIP 2, TEXAS AND PACIFIC CALLEJADO COMPANY SURVEY, COUNTY OF EL PASO, TEXAS

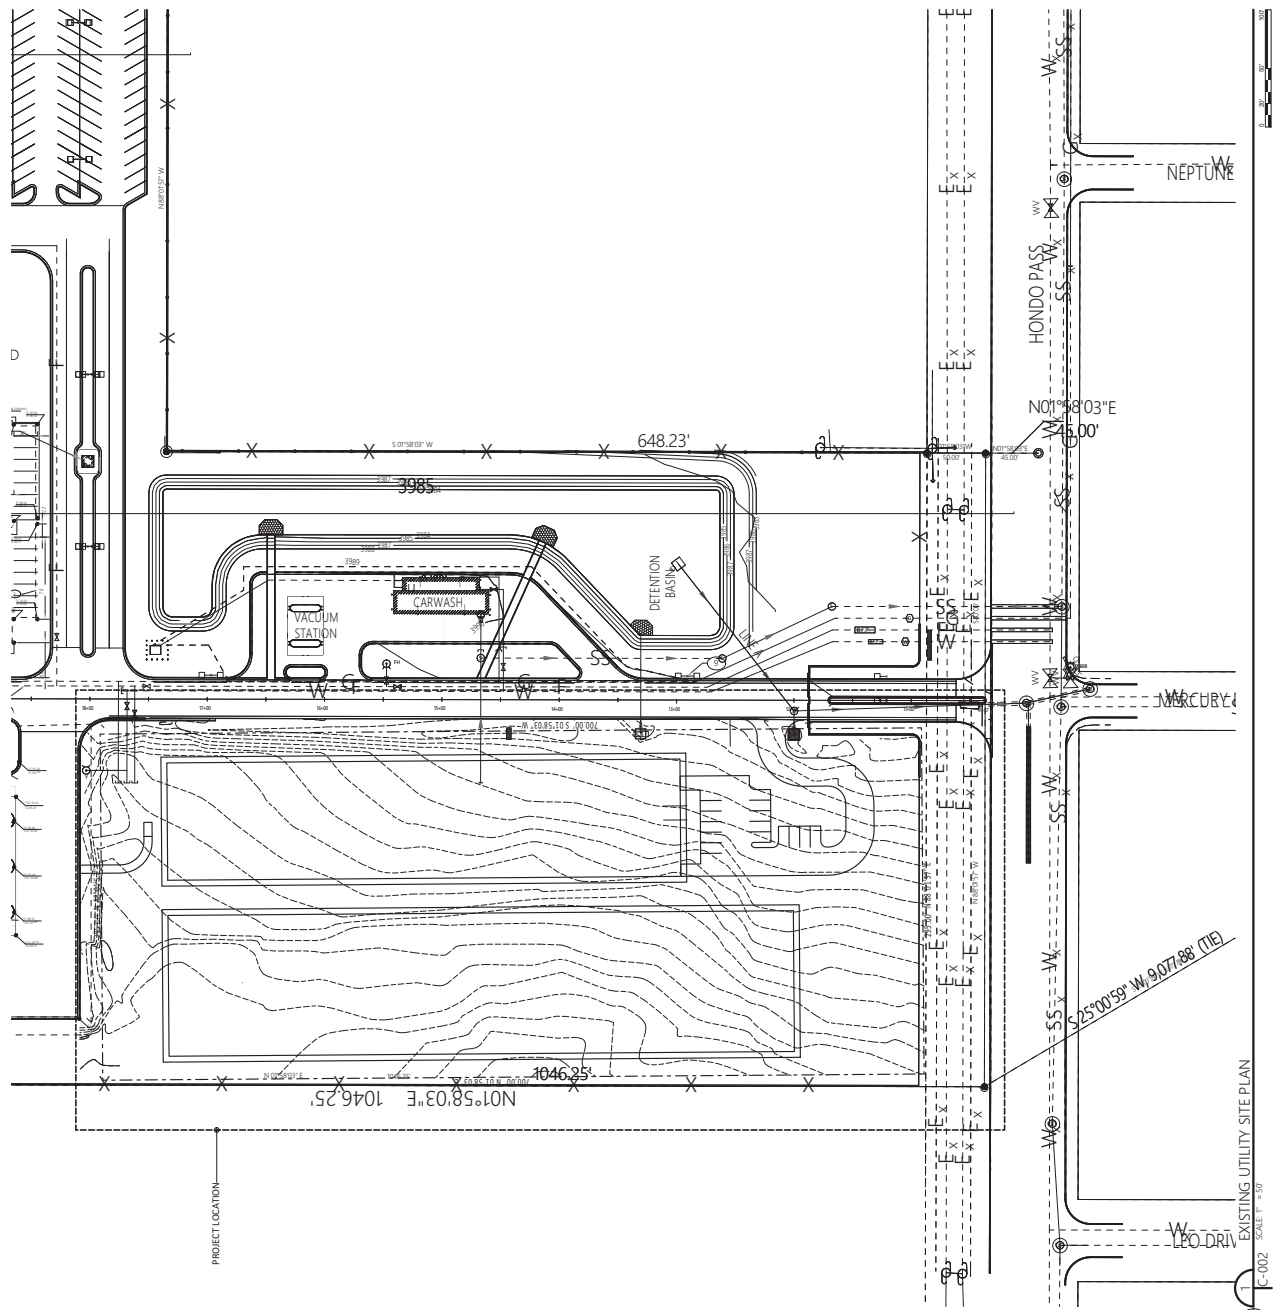


EXISTING UTILITY SITE PLAN  
SCALE 1" = 50'



19C0025\_0001\_SKT\_1\_15May19

19C0025\_0001\_SKT\_1\_15May19

NOTE: REFER TO SHEET C-302 SITE UTILITY PLAN FOR PIPE ELEVATIONS

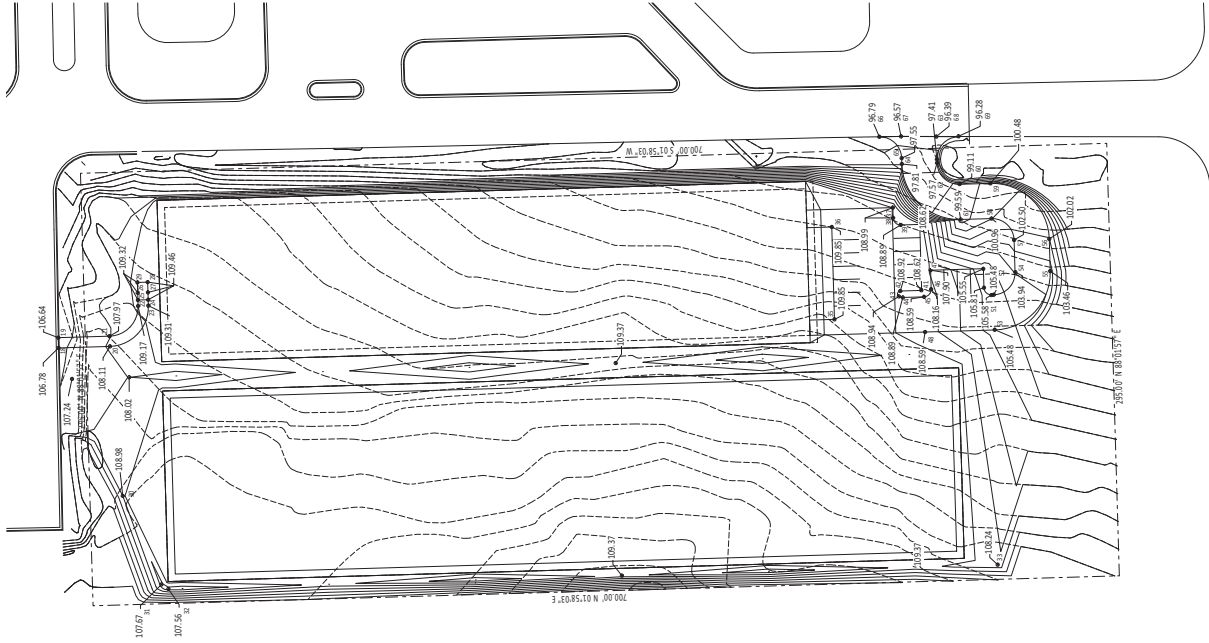

N  
SITE GRADING PLAN  
C-101  
SCALE: 1" = 40'

**LEGAL DESCRIPTION**

BEING THAT CERTAIN PARCELS OF LAND SITUATED WITHIN THE EASTERN RANGE OF THE FIRST BLESS MILITARY RESERVATION WITHIN SECTION 3, BLOCK 81, TOWNSHIP 2, RANGE 2, TEXAS AND PACIFIC RAILROAD COMPANY SURVEY, COUNTY OF EL PASO, TEXAS

**GENERAL NOTES**

1. ALPHERMETER EROSION AND SEDIMENT CONTROL MEASURES SHALL BE INSTALLED PRIOR TO THE COMMENCEMENT OF ANY GROUND DISTURBANCE ACTIVITIES.
2. THE APPROPRIATE EROSION CONTROL DEVICES SHALL BE INSTALLED PRIOR TO ANY GROUND DISTURBANCE ACTIVITIES. THE EROSION CONTROL DEVICES SHALL BE MAINTAINED DURING THE TIME SUCH SPECIAL CONDITIONS EXIST. THE SUE FENCE SHOWN ON PLAN IS A SUGGESTED LAYOUT. CONTRACTOR MAY SUBMIT AN ALTERNATE EROSION CONTROL PLAN TO THE CONTRACTING OFFICE FOR APPROVAL.
3. SEDIMENT COLLECTED BEHIND THE SUE FENCES OR SEDIMENT BARRIER SHALL BE REMOVED WHEN SEDIMENT TECHNIQUES CAN THROU THE HEIGHT OF THE BARRIER.
4. SEDIMENT FILTERS AND SUE FENCES SHALL BE MAINTAINED AND REPAIRED AS NEEDED. MORE MAINTENANCE SHALL INCLUDE BUT IS NOT LIMITED TO SEDIMENT REMOVAL, BARRIER REPAIR AND/OR REPLACEMENT.
5. THE CONTRACTOR SHALL, AT HIS OWN EXPENSE, PERIODICALLY WATER THE SITE TO CONTROL DUST.
6. SEDIMENTATION AND EROSION CONTROL MEASURES SHALL BE REMOVED FOLLOWING COMPLETION OF THE PROJECT AND THE AREA SHALL BE RESTORED TO ORIGINAL CONDITIONS. AREAS WHERE EROSION OCCURS MUST BE REPAIRED AND THE AREA SHALL BE REPAIRED OR REVEALED AND SHALL MEET OR EXCEED PRE DEVELOPMENT CONDITIONS.



5

4

3

2

1

A

B

C

D

E

F

G

H

I

J

K

L

M

N

O

P

Q

R

S

T

U

V

W

X

Y

Z

AA

AB

AC

AD

AE

AF

AG

AH

AI

AJ

AK

AL

AM

AN

AO

AP

AQ

AR

AS

AT

AU

AV

AW

AX

AY

AZ

BA

BB

BC

BD

BE

BF

BG

BH

BI

BJ

BK

BL

BM

BN

BO

BP

BQ

BR

BS

BT

BU

BV

BW

BX

BY

BZ

CA

CB

CC

CD

CE

CF

CG

CH

CI

CJ

CK

CL

CM

CN

CO

CP

CQ

CR

CS

CT

CU

CV

CW

CX

CY

CZ

DA

DB

DC

DD

DE

DF

DG

DH

DI

DJ

DK

DL

DM

DN

DO

DP

DQ

DR

DS

DT

DU

DV

DW

DX

DY

DZ

EA

EB

EC

ED

EE

EF

EG

EH

EI

EJ

EK

EL

EM

EN

EO

EP

EQ

ER

ES

ET

EU

EV

EW

EX

EY

EZ

FA

FB

FC

FD

FE

FF

FG

FH

FI

FJ

FK

FL

FM

FN

FO

FP

FQ

FR

FS

FT

FU

FV

FW

FX

FY

FZ

GA

GB

GC

GD

GE

GF

GG

GH

GI

GJ

GK

GL

GM

GN

GO

GP

GQ

GR

GS

GT

GU

GV

GW

GX

GY

GZ

HA

HB

HC

HD

HE

HF

HG

HH

HI

HJ

HK

HL

HM

HN

HO

HP

HQ

HR

HS

HT

HU

HV

HW

HX

HY

HZ

IA

IB

IC

ID

IE

IF

IG

IH

II

IJ

IK

IL

IM

IN

IO

IP

IQ

IR

IS

IT

IU

IV

IW

IX

IY

IZ

JA

JB

JC

JD

JE

JF

JG

JH

JI

IJ

JK

KL

LM

LN

LO

LP

LQ

LR

LS

LT

LU

LV

LW

LX

LY

LZ

MA

MB

MC

MD

ME

MF

MG

MH

MI

MJ

MK

ML

MM

MN

MO

MP

MQ

MR

MS

MT

MU

MV

MW

MX

MY

MZ

NA

NB

NC

ND

NE

NF

NG

NH

NI

NJ

NK

NL

NM

NN

NO

NP

NQ

NR

NS

NT

NU



REVISIONS	DATE

REVIEW: 5-7-2019 DESIGNED FOR PERMIT DRAWN BY: [redacted] CHECKED BY: [redacted] DATE: 5-7-2019 PLOT DATE: 5/8/2019 PLOT SCALE: REFER TO DRAWING	APPROVED BY: [redacted] DATE: 5-7-2019 PLOT DATE: 5/8/2019 PLOT SCALE: REFER TO DRAWING
--	--

FY19 DEPARTMENT OF HOMELAND SECURITY-CENTRALIZED PROCESSING CENTER-EL PASO, TEXAS  
SOLICITATION NO. W8126619R0097

SHEET NO. C-102
SHEET 15 OF 29


LEGAL DESCRIPTION

BEING THAT CERTAIN PARCELS OF LAND SITUATED WITHIN THE EASTERN RANGE OF THE FOOT BLISS MILITARY RESERVATION WITHIN SECTION 3, BLOCK 81, TOWNSHIP 2, TEXAS AND PACIFIC RAILROAD COMPANY SURVEY, COUNTY OF EL PASO, TEXAS




SITE UTILITY PLAN

SCALE: 1" = 40'

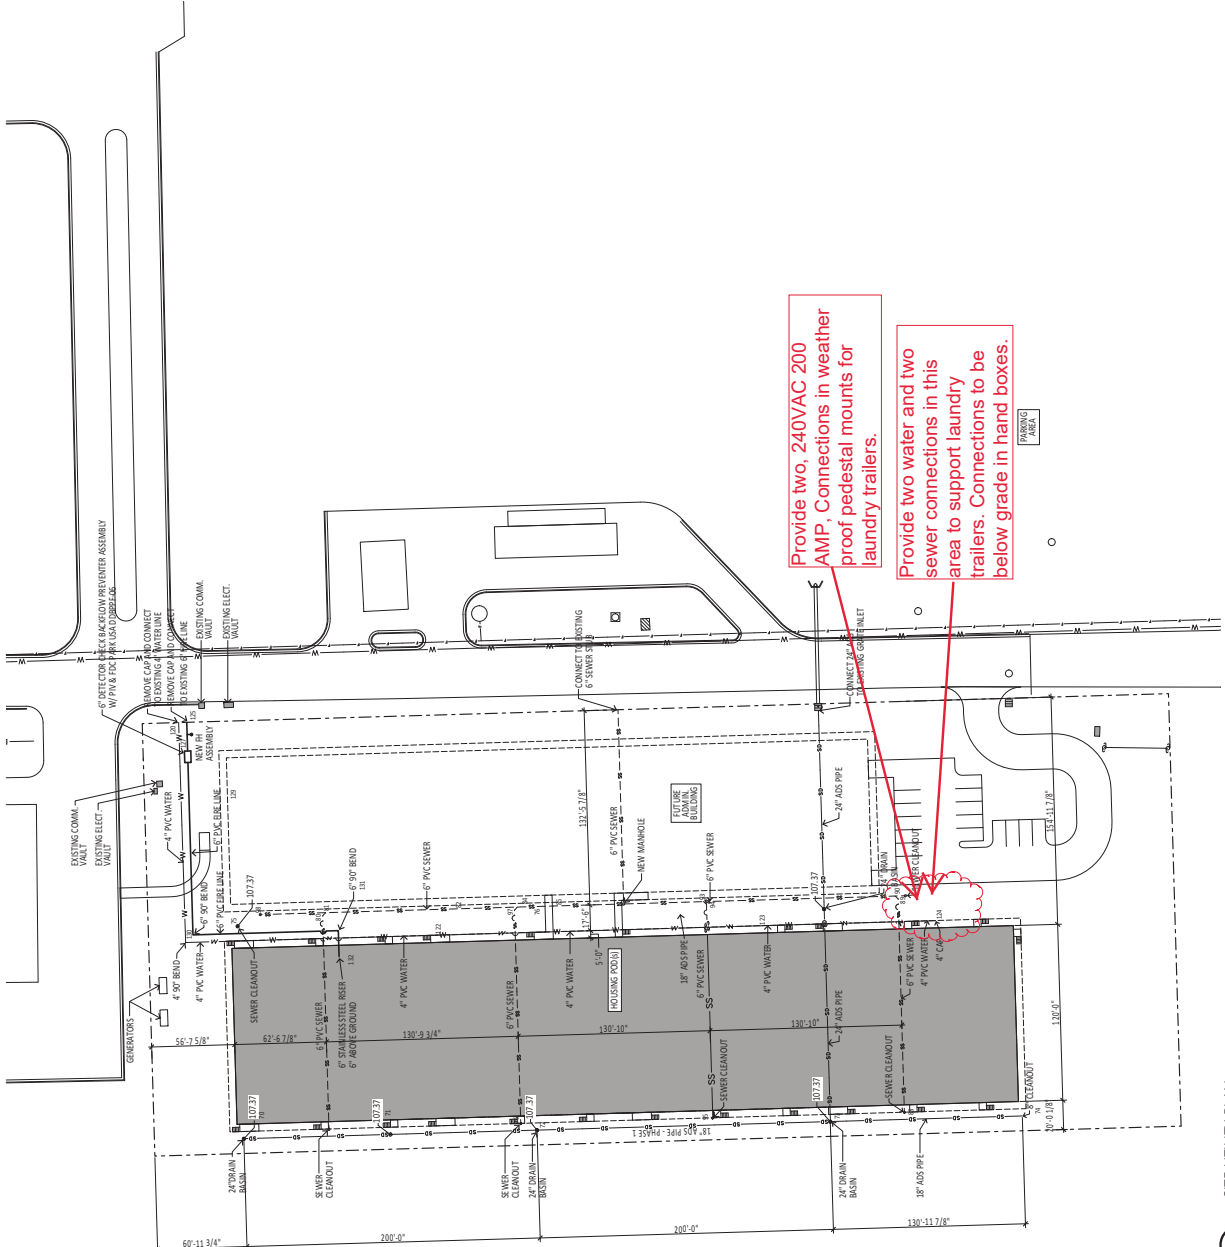


19C0025\_0001\_SKT\_1\_15May19






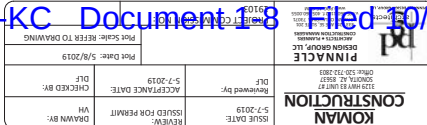

SHEET TITLE:	SHEET NO.	SHEET
CIVIL DETAILS	C-5	

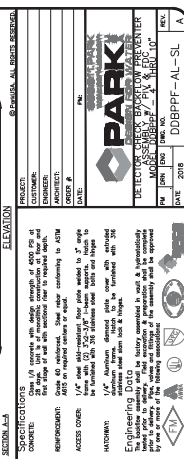


BIMcloud: BIM2 - BIMcloud Base for ARCHICAD 22/21 Paso Processing Center (Prelim. Plans)

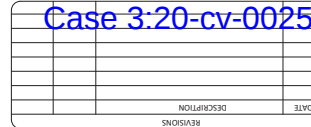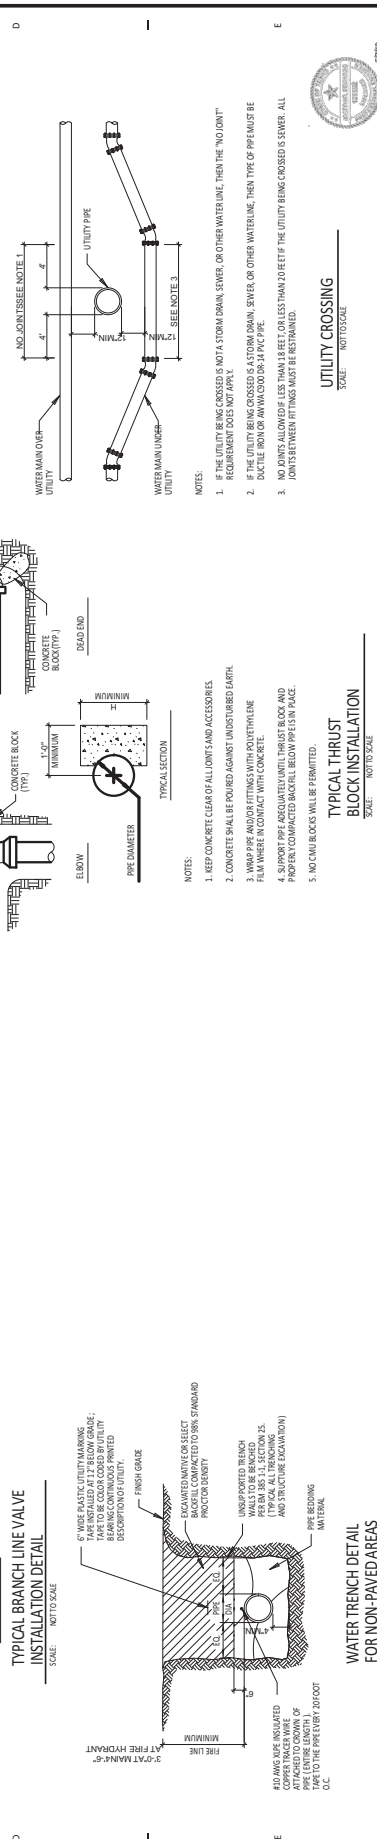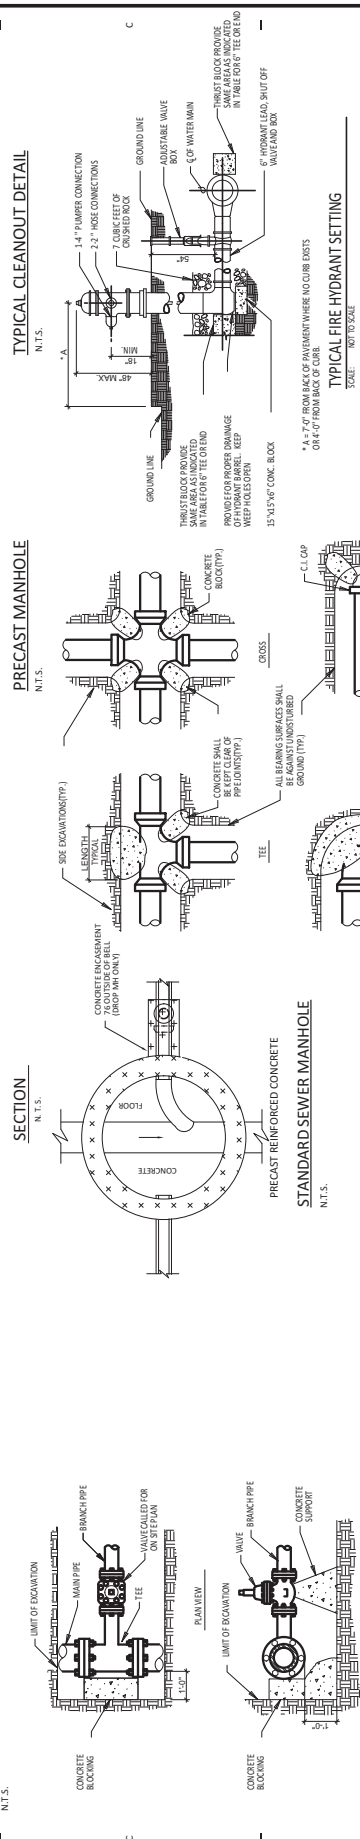[illegible]

SCALE - NOT TO SCALE	
1	2 3 4 5


  
 David P. King



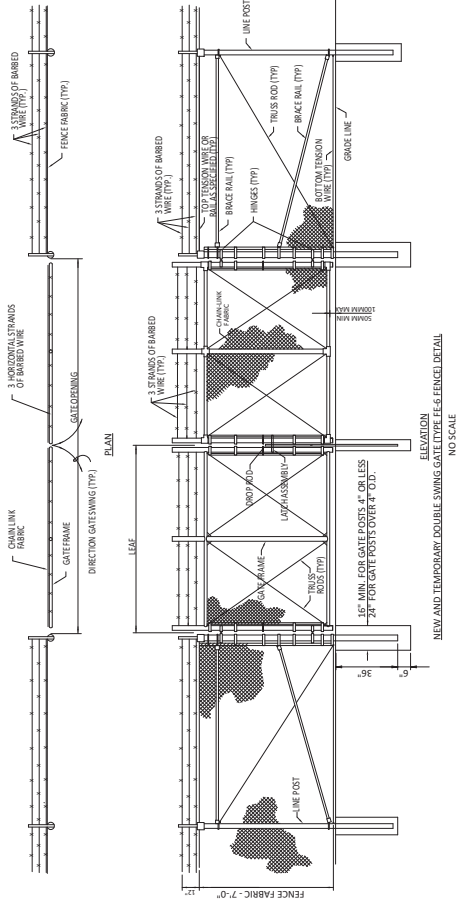

GATE DETAIL


Σ

**NOTES:**

1. DETAILS SHOWN ARE TO CLARIFY REQUIREMENTS AND ARE NOT INTENDED TO LIMIT OTHER TYPES OF FENCE SECTIONS AND METHODS OF INSTALLATION.
2. SWING GATES SHALL BE CONTRIBUTE WITH DROP DOGS, LATCH ASSEMBLY AND KEYS BEING KEPT AS NOTED.
3. ALL GATE FRAMES SHALL BE A MINIMUM 1/4" MINIMUM (ROUND) OR 3/8" (SQUARE) THICK. THE GATE FRAME SHALL BE CONSTRUCTED OF HORIZONTAL BRACE MEMBER (USED IN LIEU OF TRUSSPODS TO BRACE ALL VERTICAL GATE FRAMES) SHALL BE RESPONSIBLE FOR THE PROPER HINGED CONSTRUCTION OF ALL GATES SUPPLIED.
4. GATES SHALL BE SUPPLIED WITH ASSILOS.


**NOTES:**

1. DETAILS SHOWN ARE TO CLARIFY REQUIREMENTS AND ARE NOT INTENDED TO LIMIT OTHER TYPES OF FENCE SECTIONS AND METHODS OF INSTALLATION.
2. WIRE TYPE, SIZE AND BRACES SHALL BE SPECIFIED ON THE PLACED SIDE OF THE FENCE ASSEMBLY. SQUARE LINK FABRIC SHALL BE PLACED ON THE OPPOSITE SIDE OF THE CHAIN LINK.
3. UNLESS SPECIFICALLY SHOWN OR SPECIFIED, ALL FENCE SHALL HAVE THE ARJON EXTENDING OUTWARD.
4. C-SECTION POSTS SHALL BE INSTALLED 2'0" TO 4'0" INSIDE THE POST TO BE SPECIFICALLY FILLED WITH CON. UP TO THE TOP OF THE

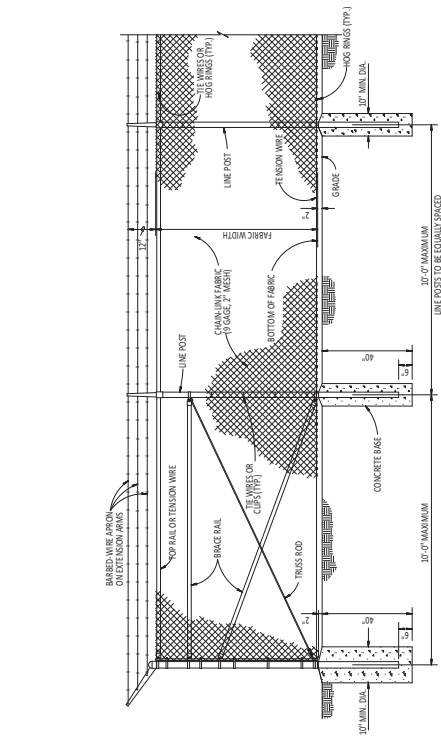

NEW AND TEMPORARY CHAIN-LINK SECURITY FENCE DETAIL


SCAL

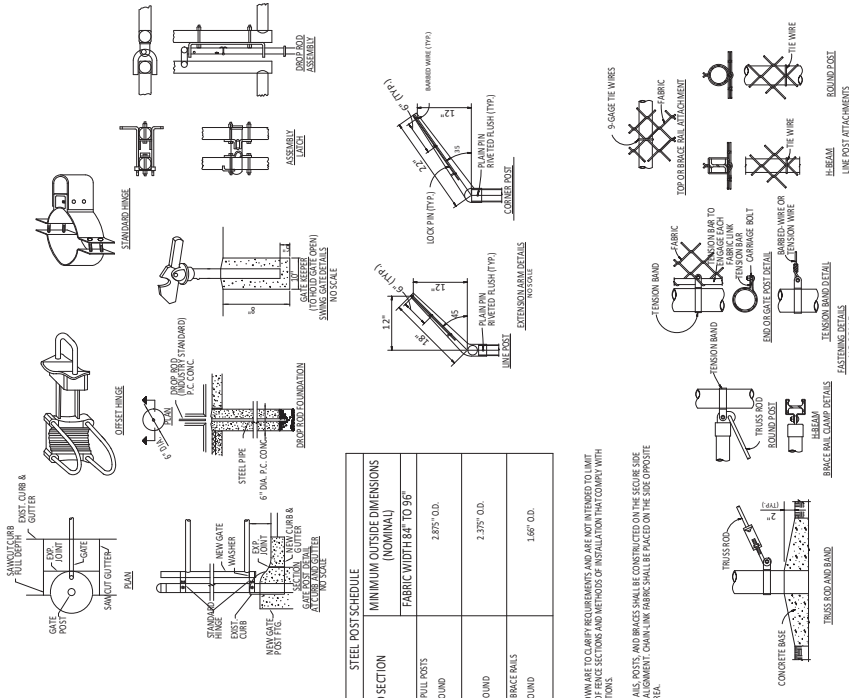

STEEL POST SCHEDULE		MINIMUM OUTSIDE DIMENSIONS (NOMINAL)
USE AND SECTION		FABRIC WIDTH 84" TO 96"
CORNER, END & PULL POSTS TUBULAR - ROUND		2.375" O.D.
LINE POSTS TUBULAR - ROUND		2.375" O.D.
TOP, BOTTOM & BRACE RAILS TUBULAR - ROUND		1.66" O.D.

510

1. DETAILS SHOWN ARE TO CLARIFY REQUIREMENTS AND ARE NOT INTENDED TO LIMIT OTHER TYPES OF FENCE SECTIONS AND METHODS OF INSTALLATION THAT COMPLY WITH THE SPECIFICATIONS.
2. WIRE TIES, RAILS, POSTS, AND BRACES SHALL BE CONSTRUCTED ON THE SECURE SIDE OF THE FENCE ALIGNMENT. CHAIN-LINK FABRIC SHALL BE PLACED ON THE SIDE OPPOSITE THE SECURE AREA.

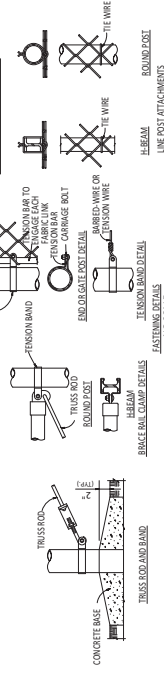

[illegible]

KC Doc	
Plot Scale: REFER TO DRAWING	
Plot Date: 5/8/2019	
CHECKED BY: DIF	DATE:
DRAWN BY: VH	PERMIT:

ISSUE DATE: 5-7-2019	Reviewed by: DLF	ACCEPTANCE 5-7-2019
-------------------------	---------------------	------------------------

**COMAN CONSTRUCTION**


L/20 Page 14 of 34

SHEET TITLE:  
UTILITY PROFILES


SHEET NO.  
C-601

SHEET 9 OF 29

PLAN & PROFILE AT PHASE 1 STORM DRAIN (WEST PROPERTY LINE)

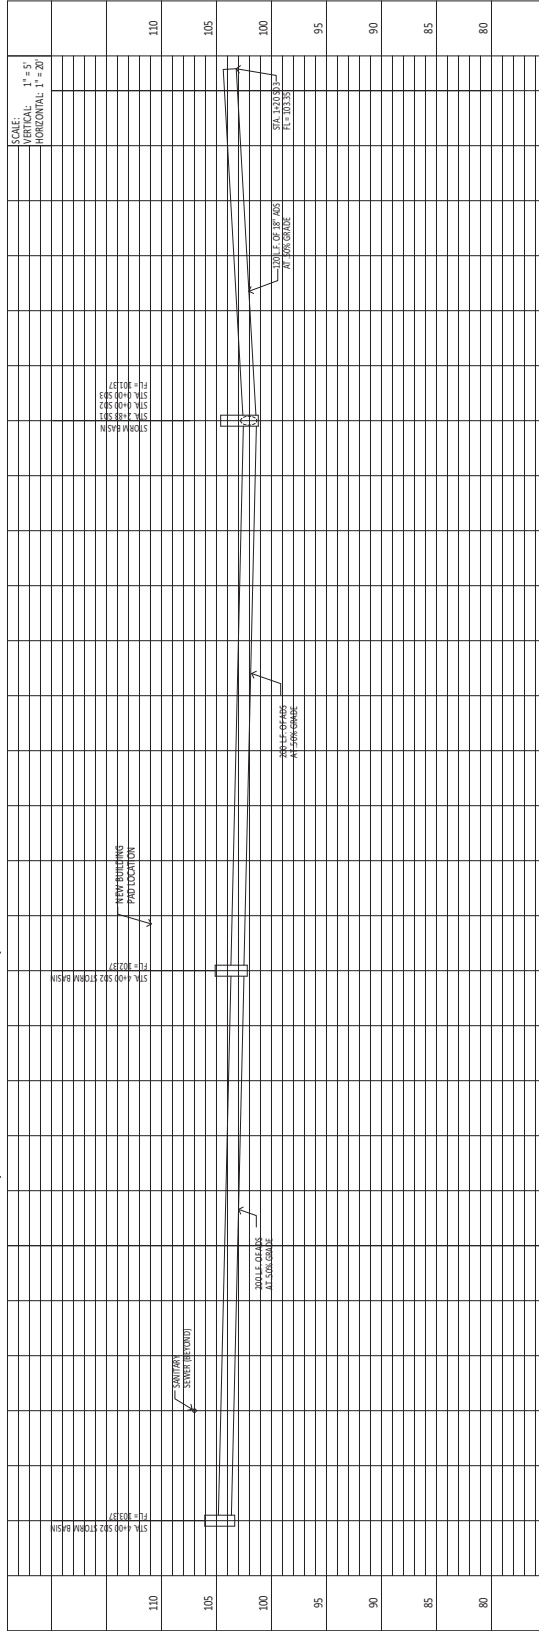

### PLAN & PROFILE AT PHASE 1 STORM DRAIN (TRANSVERSE)

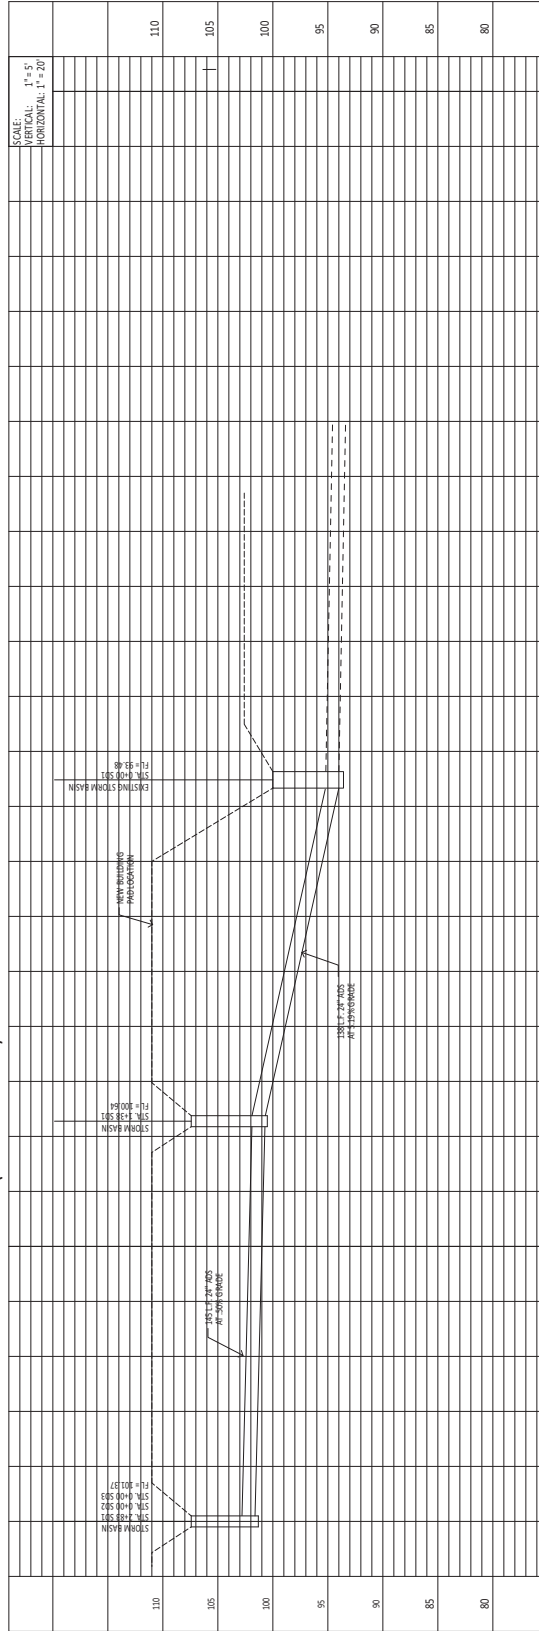









## CHAPTER 3 - BUILDING BLOCKS

**801.1 Scope.** The provisions of Chapter 8 shall apply where required by Chapter 2 or where referenced by a requirement in this document.

**Advisory 801.1 Scope.** Facilities covered by these requirements are also subject to the requirements of the other chapters. For example, 806 addresses guestrooms in transient lodging facilities while 902 contains the technical specifications for dining surfaces. If a transient lodging facility contains a restaurant, the restaurant must comply with requirements in other chapters such as those applicable to certain dining surfaces.

## 802 Wheelchair Spaces, Companion Seats, and Designated Aisle Seats

802.1 Wheelchair Spaces. Wheelchair spaces shall comply with 802.1.

**EXCEPTION:** Slopes not steeper than 1:48 shall be permitted.

**802.1.2 Width.** A single wheelchair space shall be 36 inches (915 mm) wide minimum. Where two adjacent wheelchair spaces are provided, each wheelchair space shall be 33 inches (840 mm) wide minimum.

36 min 33

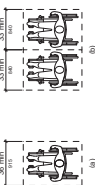


FIGURE 802.1.2

WIDTH OF WHEELCHAIR SPACES

**802.1.3 Depth.** When a wheelchair space can be entered from the front or rear, the wheelchair space shall be 48 inches (1220 mm) deep minimum. Where a wheelchair space can be entered only from the side, the wheelchair space shall be 60 inches (1525 mm) deep minimum.

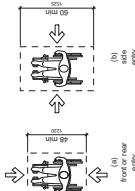


FIGURE 802.1.3

**302.1.4 Approach.** Wheelchair spaces shall adjoin accessible routes. Accessible routes shall not overlap wheelchair spaces.

**Advisory 802.1.4 Approach.** Because accessible routes serving wheelchair spaces are not permitted to overlap the clear floor space at wheelchair spaces, access to any wheelchair space cannot be through another wheelchair space.

**802.1.5 Overlap.** Wheelchair spaces shall not overlap circulation paths.

**Advisory 802.1.5 Overlap.** The term "circulation paths" used in Section 802.1.5 means aisle width required by applicable building or life safety codes for the specific assembly occupancy. Where the circulation path provided is wider than the required aisle width, the wheelchair space may intrude into that portion of the circulation path that is provided in excess of the required aisle width.







REVISIONS	DATE	DESCRIPTION


REVIEW: ISSUED FOR PERMIT	DATE: 5-7-2019	APPROVED BY: [Signature]
DRAWN BY: [Signature]	CHECKED BY: [Signature]	DATE: 5-7-2019
PROJECT: REFERENCE TO DRAWING	PROJECT: REFERENCE TO DRAWING	PROJECT: REFERENCE TO DRAWING

FY19 DEPARTMENT OF HOMELAND SECURITY-CENTRALIZED PROCESSING CENTER-EL PASO, TEXAS  
SOLICITATION NO. M0126619R0097

SHEET NO.	A-002
SHEET 15 OF 29	



**LEGAL DESCRIPTION**  
BEING THAT CERTAIN PARCELS OF LAND SITUATED WITHIN THE EASTERN RANGE OF THE FIRST BLESS MILITARY RESERVATION WITHIN SECTION 3, BLOCK 81, TOWNSHIP 2, TEXAS AND PACIFIC RAILROAD COMPANY SURVEY, COUNTY OF EL PASO, TEXAS

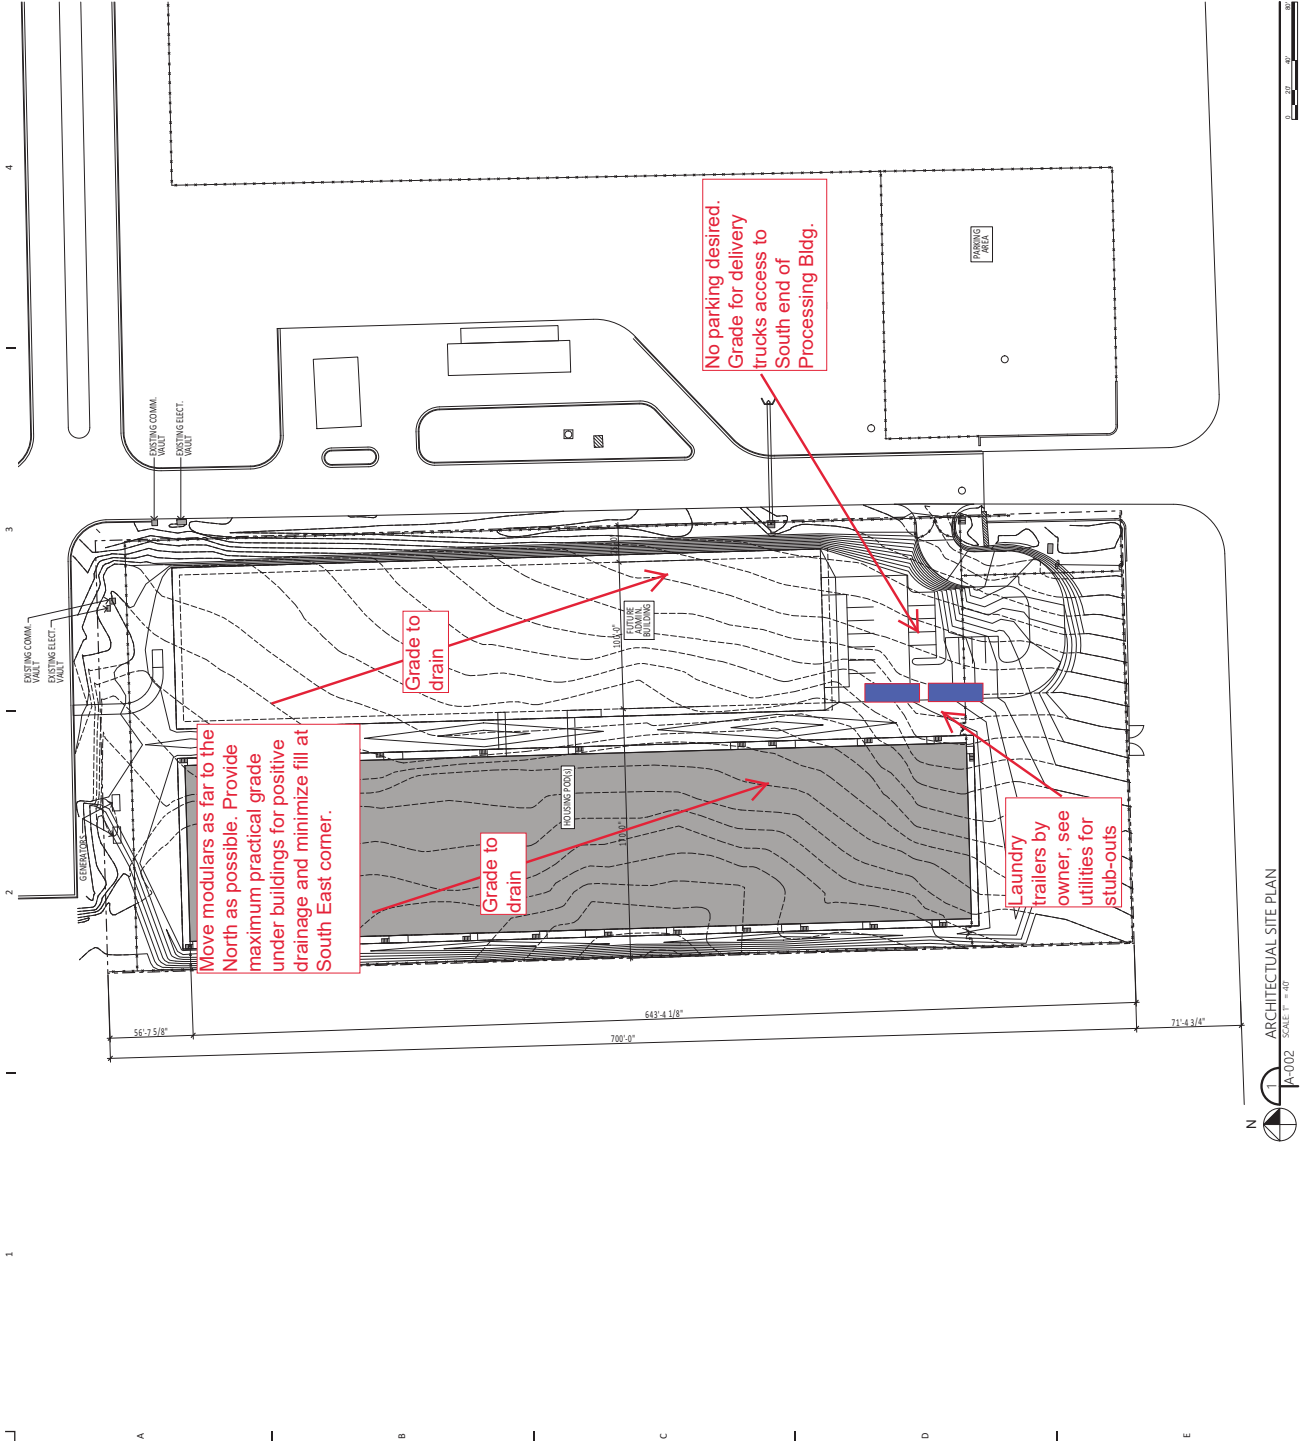

ARCHITECTURAL SITE PLAN  
A-002  
SCALE 1" = 40'

19C0025\_0001\_SKT\_1\_15May19





REVISIONS
DATE
DESCRIPTION

REVIEW: DRAWN BY: VJH	ISSUED FOR PERMIT: 5-7-2019	APPROVED DATE: 5-7-2019	CHECKED BY: DLP	PLUT DATE: 5/8/2019
PLOT SCALE: REFER TO DRAWING				

**KOMAN CONSTRUCTION**  
1115 WEST 43rd STREET  
DALLAS, TEXAS 75243  
PHONE: 214.732.3833  
FAX: 214.732.3833  
WWW.KOMANCONSTRUCTION.COM


**PINNACLE**  
ARCHITECTS & ENGINEERS  
1115 WEST 43rd STREET  
DALLAS, TEXAS 75243  
PHONE: 214.732.3833  
FAX: 214.732.3833  
WWW.PINNACLEARCHITECTS.COM

FY19 DEPARTMENT OF HOMELAND SECURITY-CENTRALIZED PROCESSING CENTER-EL PASO, TEXAS  
SOLICITATION NO. W19126G19R0097


**PROJECT TITLE:** ARCHITECTURAL SITE LIGHTING  
**SHEET NO.:** A-003  
**SHEET 15 OF 29**





1 ARCHITECTURAL SITE LIGHTING CALCULATIONS PLAN  
A-003 SCALE: 1" = 40'

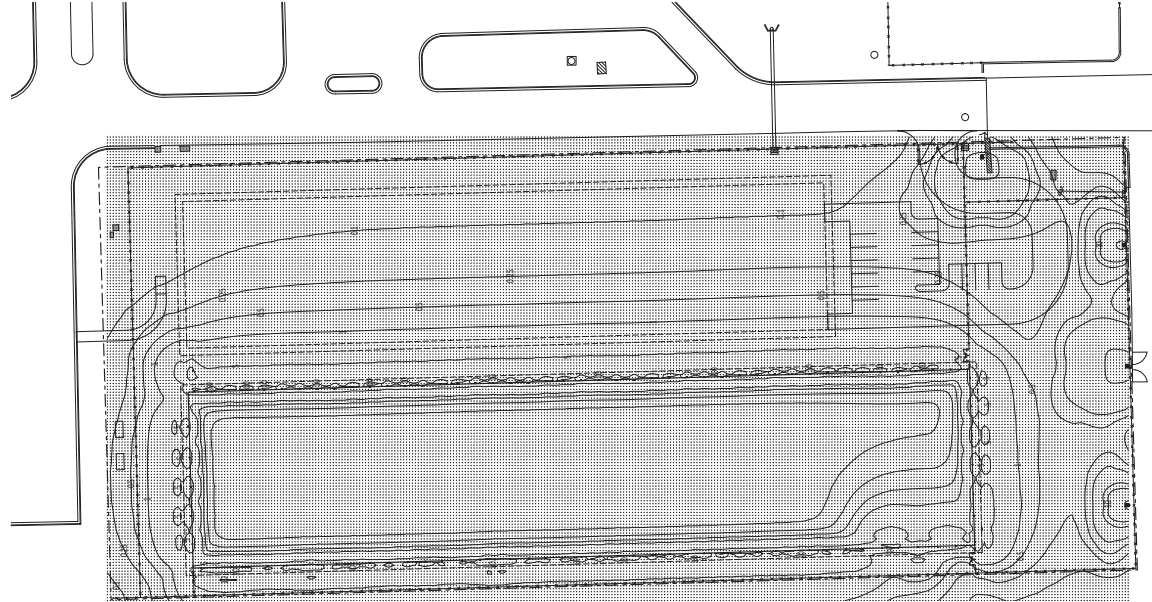


19C0025\_0001\_SKT\_1\_15May19

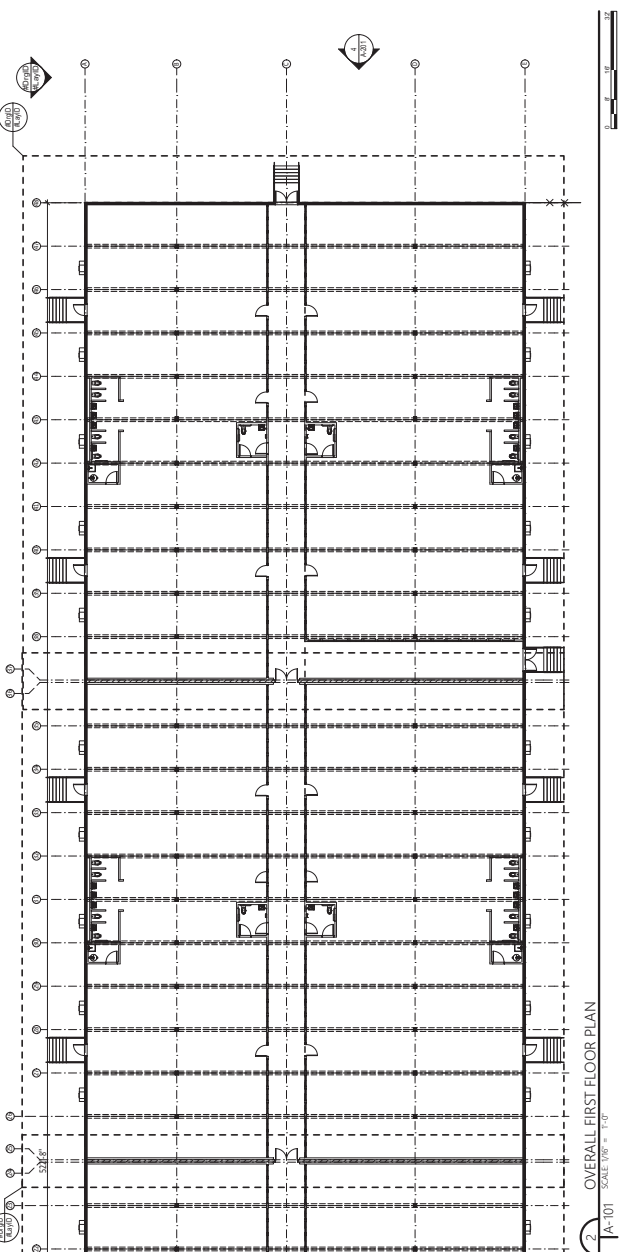



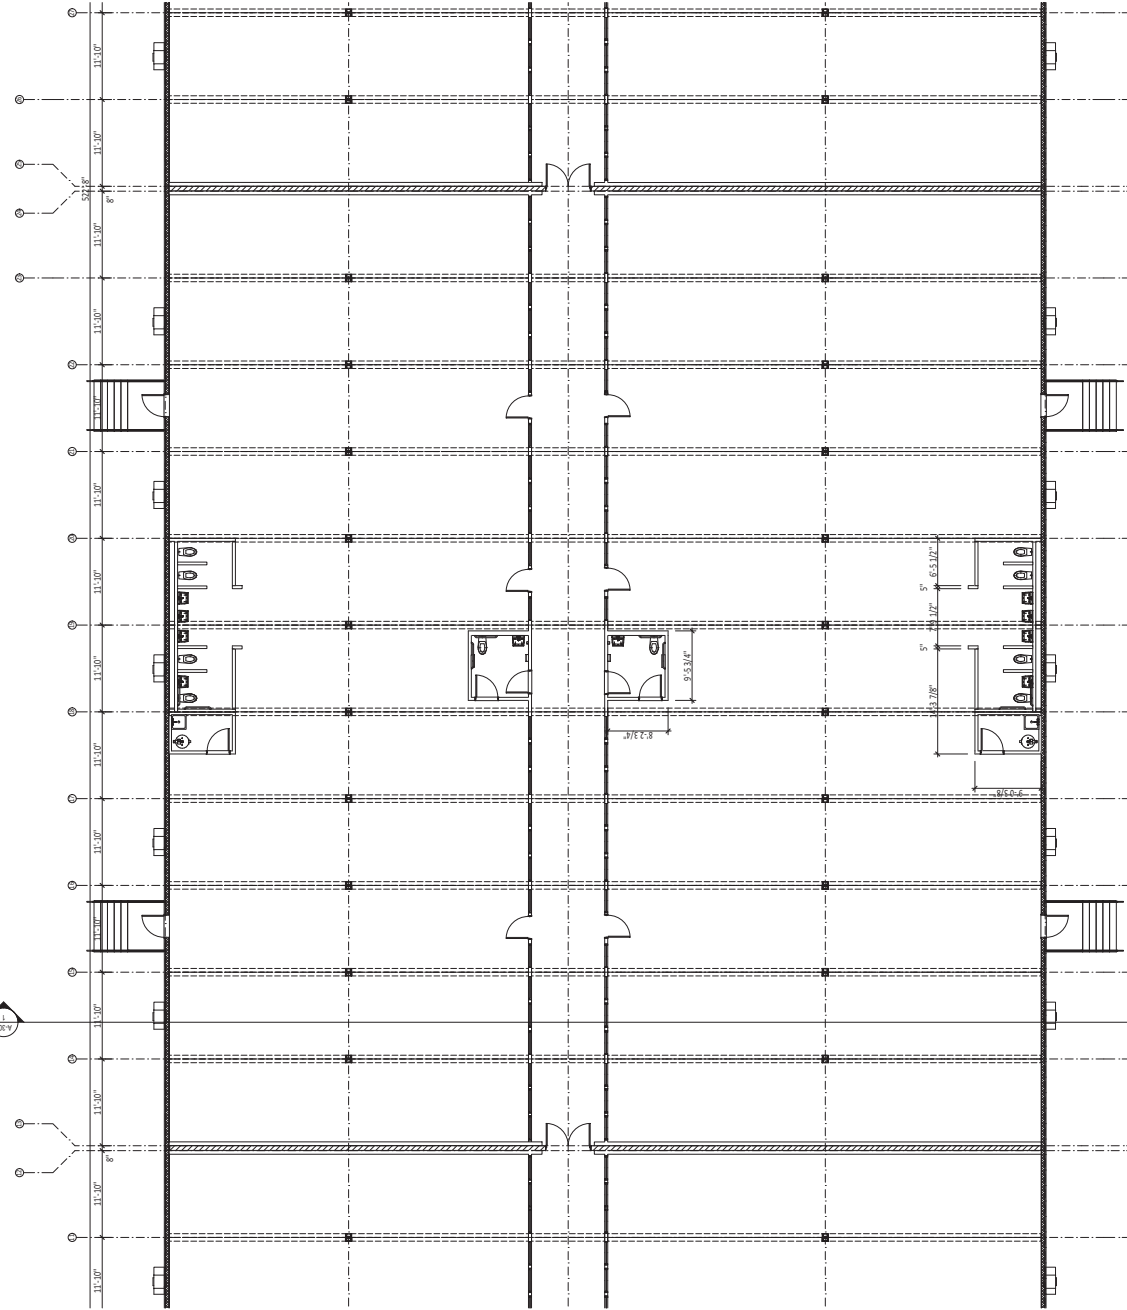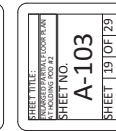

ENLARGED PARTIAL FLOOR PLAN AT POD #2

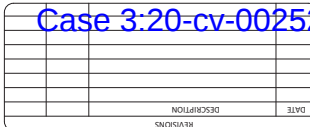


<b>REVIEWED BY:</b> NAME: [REDACTED] DATE: [REDACTED]		<b>REVIEWED BY:</b> NAME: [REDACTED] DATE: [REDACTED]	
<b>ISSUED FOR PERMIT:</b> NAME: [REDACTED]		<b>ISSUED FOR PERMIT:</b> NAME: [REDACTED]	
<b>APPROVED DATE:</b> DATE: [REDACTED]		<b>APPROVED DATE:</b> DATE: [REDACTED]	
<b>CHECKED BY:</b> NAME: [REDACTED]		<b>CHECKED BY:</b> NAME: [REDACTED]	
<b>POST SCALE:</b> DATE: [REDACTED]		<b>POST SCALE:</b> DATE: [REDACTED]	

2025 RELEASE UNDER E.O. 14176

SHEET TITLE:	
ENLARGED PARTIAL FLOOR PLAN AT HOLDING POD #3	
SHEET NO.	
A-104	
SHEET	20 OF 29

[illegible]

See comments on LS-101

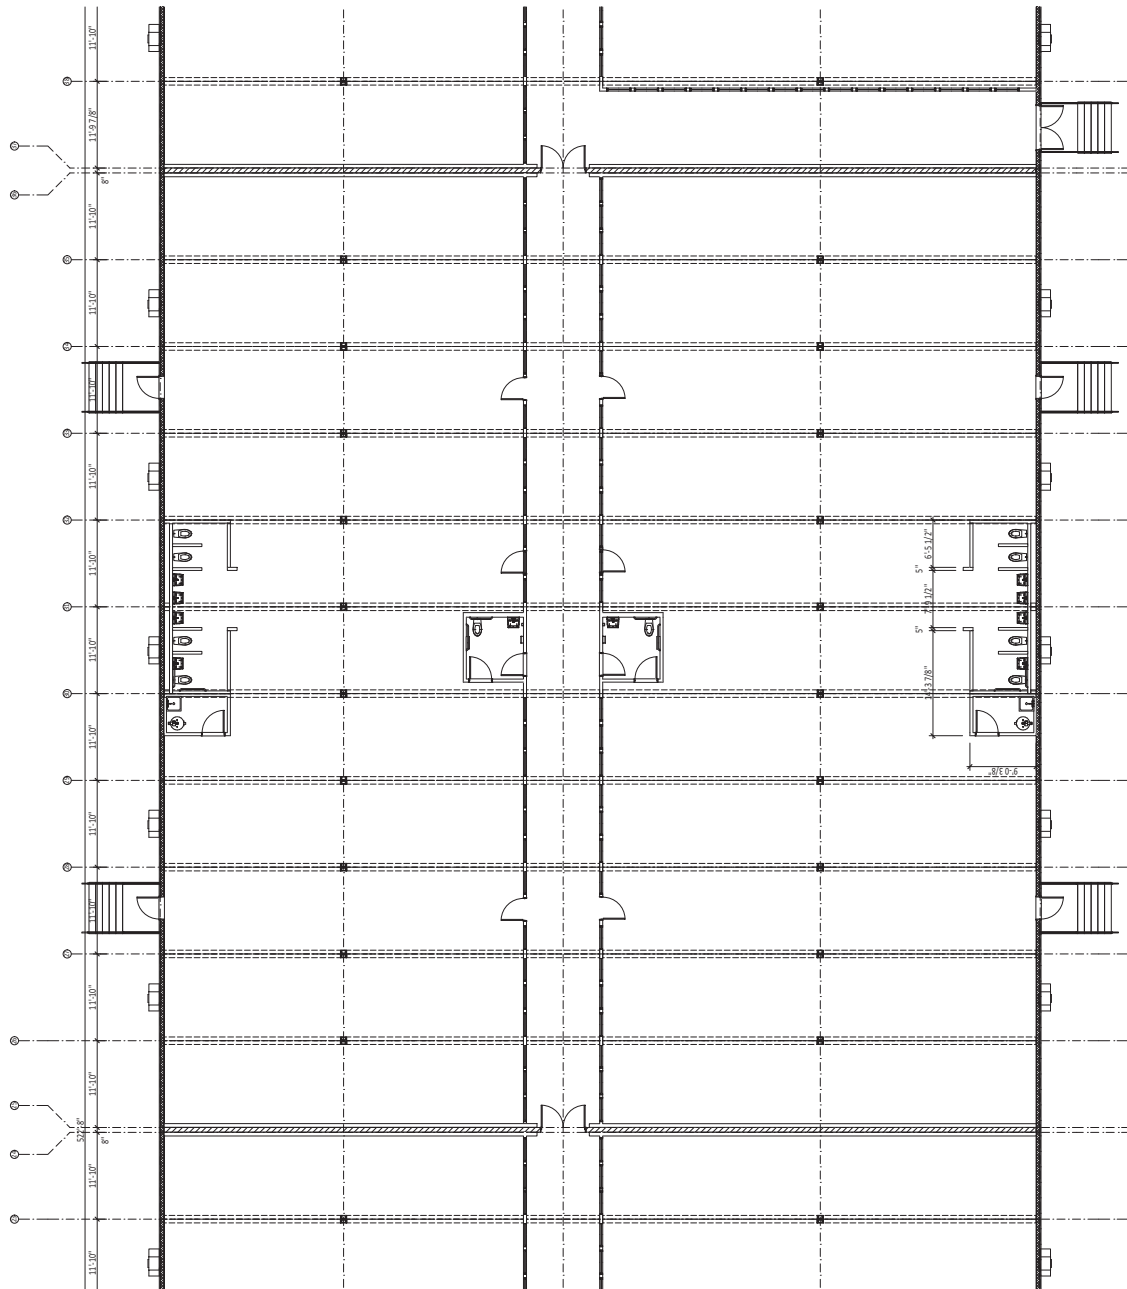

1  
A-104 SCALE 1/8" = 1'-0"



REVISIONS	DATE	DESCRIPTION

REVIEW: ISSUED FOR PERMIT	DATE: 5-7-2019	APPROVED BY: [Signature]
DRAWN BY: [Signature]	CHECKED BY: [Signature]	DATE: 5-7-2019
PROJECT: REFERENCE TO DRAWING		


FY19 DEPARTMENT OF HOMELAND SECURITY-CENTRALIZED PROCESSING CENTER-EL PASO, TEXAS  
SOLICITATION NO. W19126619R0097

SHEET NO. A-105	SHEET 21 OF 29
-----------------	----------------

GENERAL NOTES

1. THE ENGINEERED MODULAR BUILDING MANUFACTURER SHALL BE RESPONSIBLE FOR THE DESIGN AND MANUFACTURE OF THE STRUCTURES. BUILDINGS SHALL BE STAFFED AND MANAGED BY THE U.S. ARMY CORPS OF ENGINEERS.
2. THE MANUFACTURER SHALL BE RESPONSIBLE FOR THE DESIGN, FABRICATION AND ERECTION OF THE BUILDINGS IN ACCORDANCE WITH THE LATEST EDITION OF APPLICABLE CODES.
3. COMPLETE DESIGN CALCULATIONS, CERTIFIED BY A REGISTERED ENGINEER, SHALL BE SUBMITTED WITH THE SHOP DRAWINGS. ALL LOADS USED IN THE DESIGN OF THE BUILDINGS SHALL BE IDENTIFIED AND DOCUMENTED.
4. THE CONTRACTOR SHALL BE RESPONSIBLE FOR THE DESIGN OF ACCESS, STAIRS, LADDERS, AND OTHER MISCELLANEOUS STRUCTURAL FRAMING. CONTRACTOR SHALL PROVIDE AND INSTALL ALL STRUCTURAL FRAMING, STAIRS, LADDERS, AND OTHER MISCELLANEOUS STRUCTURAL FRAMING. CONTRACTOR SHALL PROVIDE AND INSTALL ALL STRUCTURAL FRAMING, STAIRS, LADDERS, AND OTHER MISCELLANEOUS STRUCTURAL FRAMING.
5. THE BUILDINGS SHALL BE DESIGNED TO SUPPORT ALL MECHANICAL EQUIPMENT, INCLUDING REFRIGERATION, HEATING, VENTILATION, AND ALL OTHER SUCH DEVICES. MECHANICAL EQUIPMENT SHALL BE INSTALLED IN ACCORDANCE WITH THE MANUFACTURER'S RECOMMENDATIONS.
6. THE CONTRACTOR SHALL VERIFY AND COORDINATE ALL FOUNDATION DIMENSIONS AND DETAILS SHOWN WITH THOSE OF THE BUILDING FURNISHED AND NOTIFY THE CONTRACTING OFFICE OF ANY REQUIRED MODIFICATIONS.

See comments on LS-101

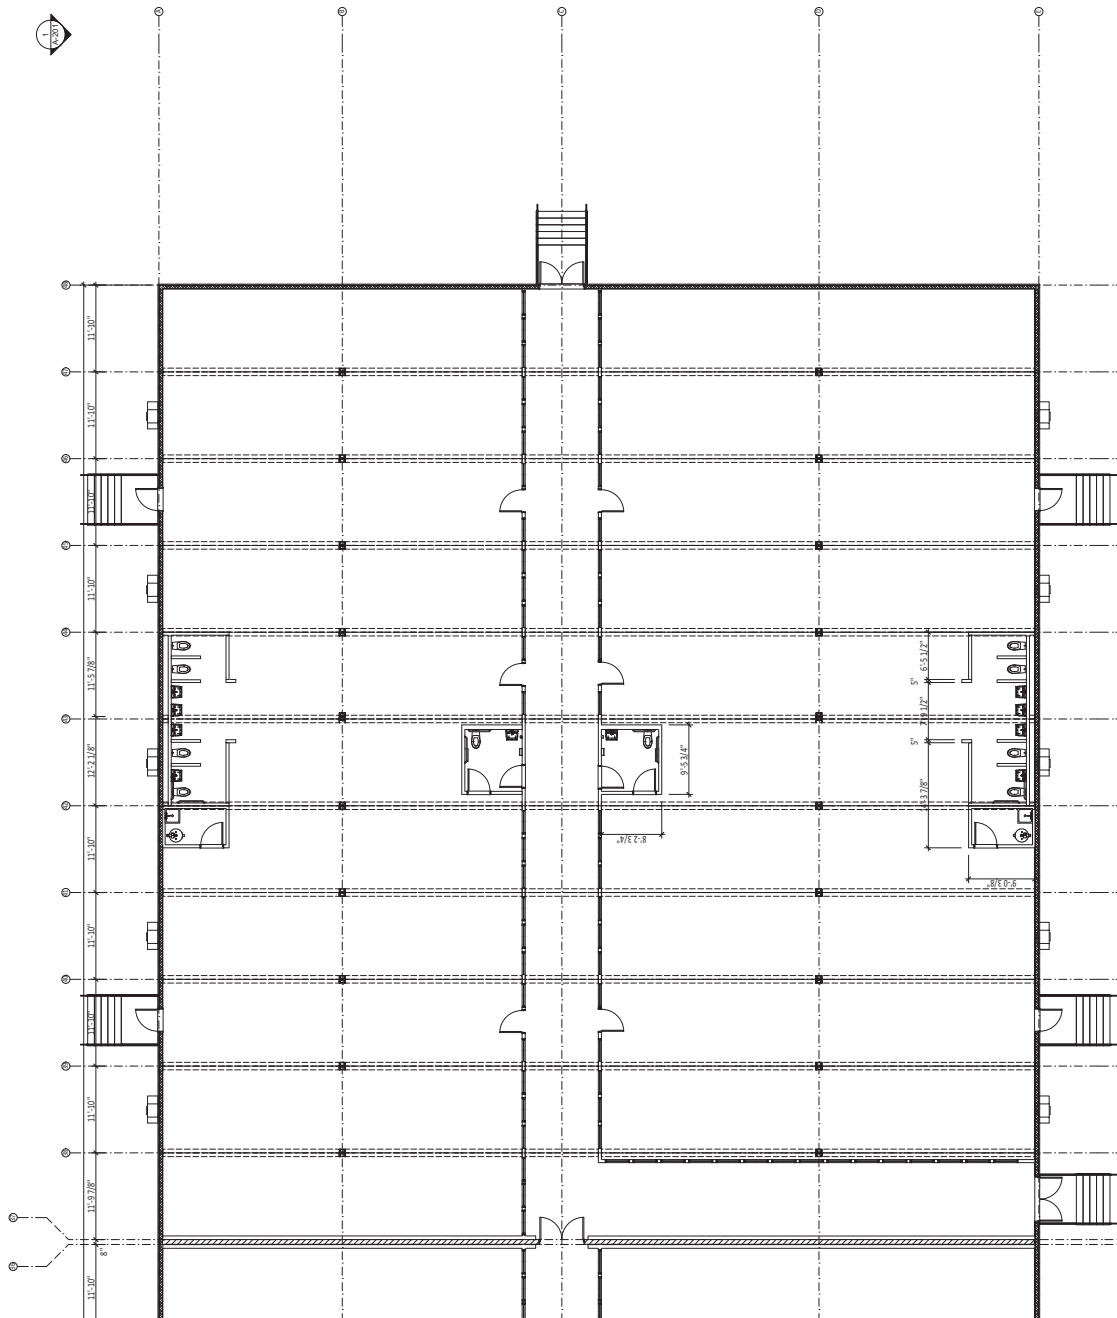

ENLARGED PARTIAL FLOOR PLAN AT POD #4

A-105 SCALE: 1/8" = 1'-0"







Independent  
RTU HVAC for  
corridor not  
shown







[illegible]

Reviewed by: _____ 5-7-2019		ACCEPTANCE DATE: _____ 5-7-2019	CHECKED BY: _____ DLF
ISSUE DATE: _____ 5-7-2019		REVIEW: _____ ISSUED FOR PERMIT	DRAWN BY: _____ VH
Plot Date: 5/8/2019			
Plot Scale: REFER TO DRAWING			

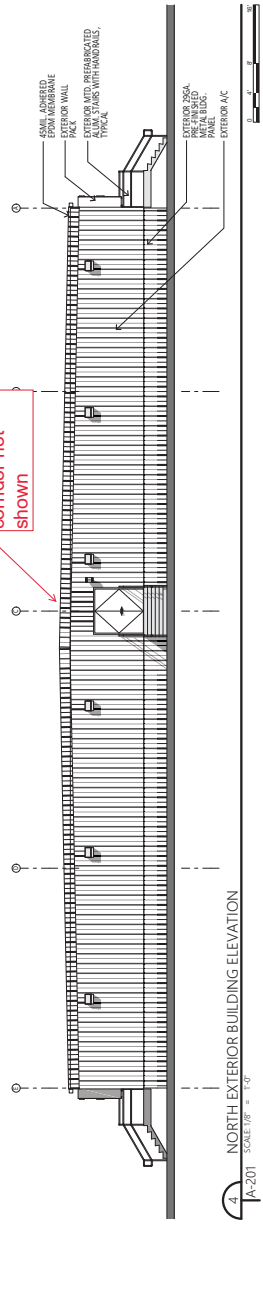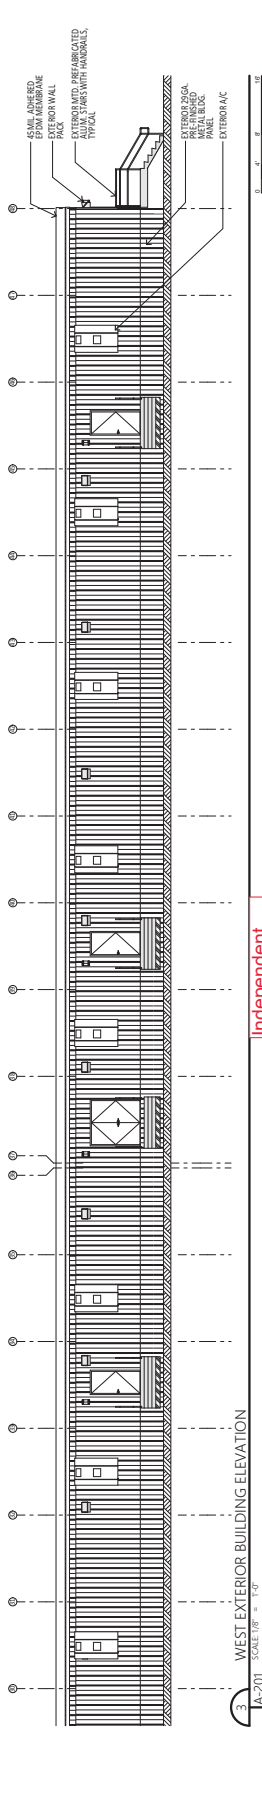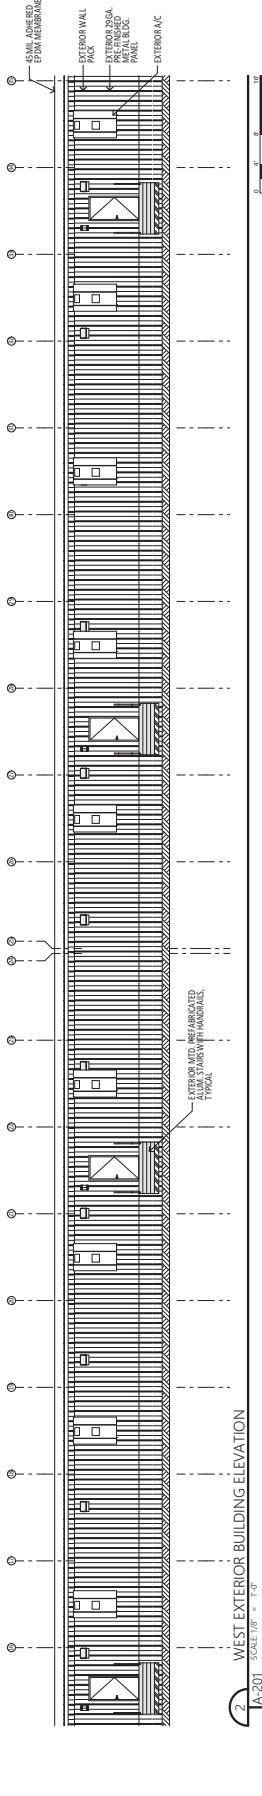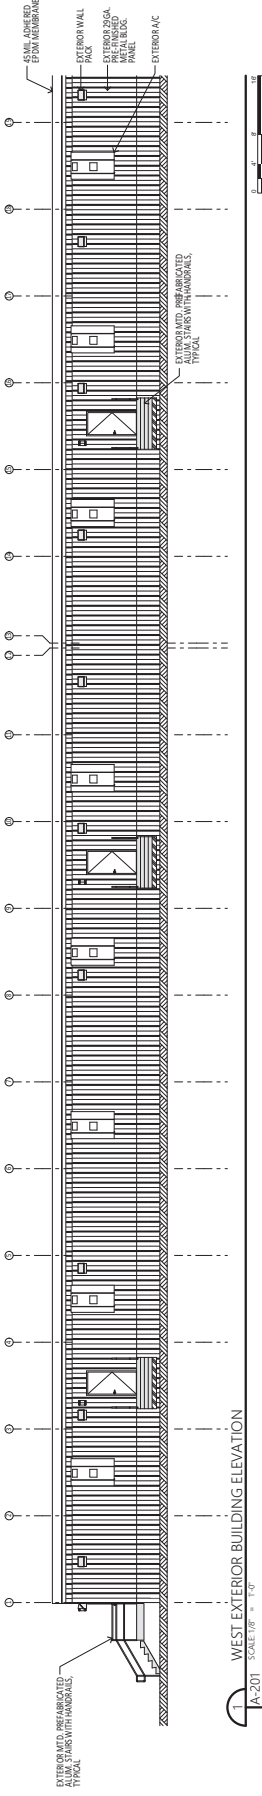

Independent  
RTU HVAC for  
corridor not  
shown




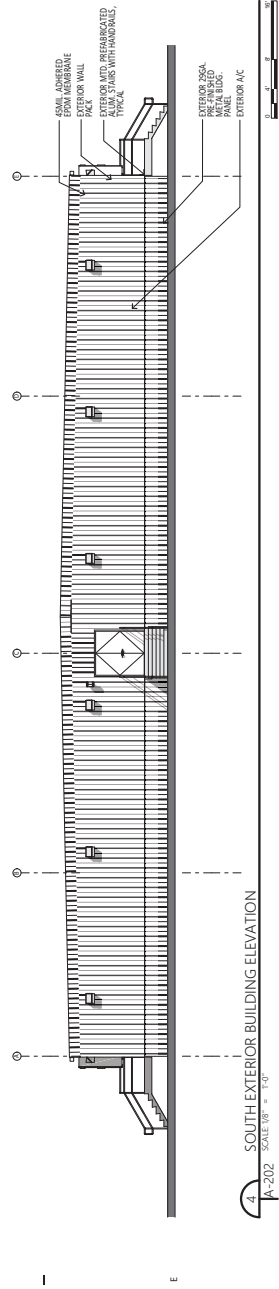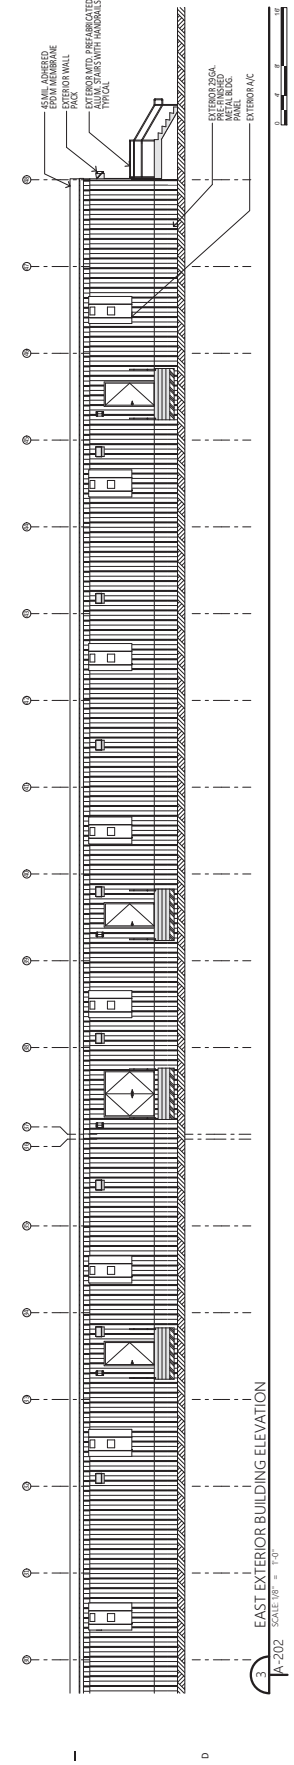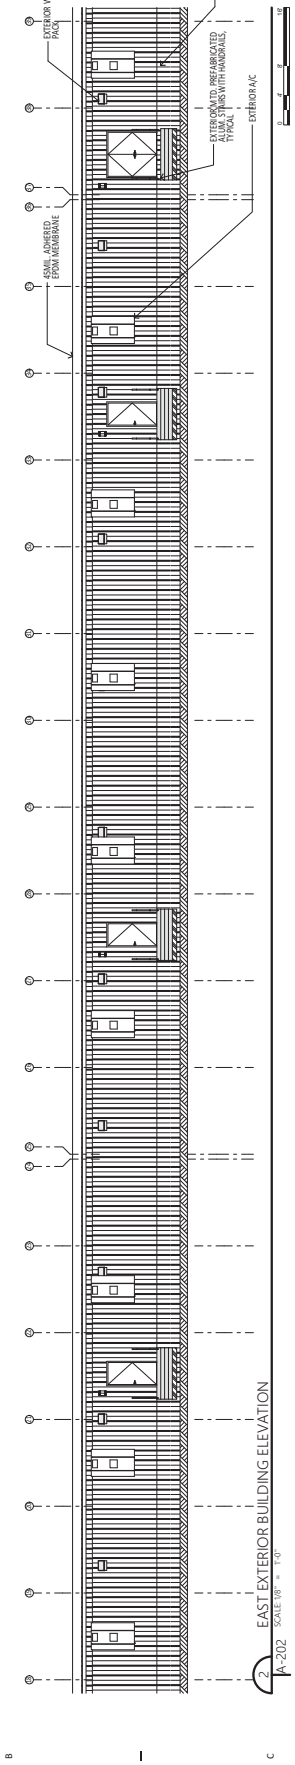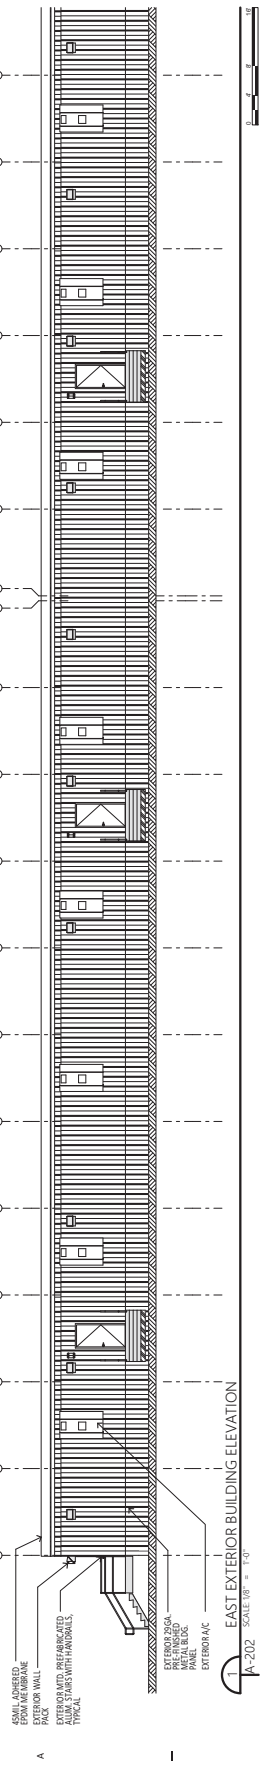



HEET NO. A-3



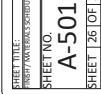





REVISIONS	DATE	DESCRIPTION


PROJECT: EL PASO CFB - P0005 FILE: El Paso CFB-P005 SERIAL # 0000 DATE: 04/10/2019 DRAWN BY: J.T. CHECKED BY: J.T. PLOT SCALE: 1/16" = 1'-0"	REVIEW: ISSUED FOR PERMIT DATE: 5-7-2019 DRAWN BY: J.T. CHECKED BY: J.T. PLOT SCALE: 1/16" = 1'-0"	ISSUE DATE: 5-7-2019 DRAWN BY: J.T. CHECKED BY: J.T. PLOT SCALE: 1/16" = 1'-0"	REVIEW: ISSUED FOR PERMIT DATE: 5-7-2019 DRAWN BY: J.T. CHECKED BY: J.T. PLOT SCALE: 1/16" = 1'-0"	PROJECT: EL PASO CFB - P0005 FILE: El Paso CFB-P005 SERIAL # 0000 DATE: 04/10/2019 DRAWN BY: J.T. CHECKED BY: J.T. PLOT SCALE: 1/16" = 1'-0"	REVIEW: ISSUED FOR PERMIT DATE: 5-7-2019 DRAWN BY: J.T. CHECKED BY: J.T. PLOT SCALE: 1/16" = 1'-0"	ISSUE DATE: 5-7-2019 DRAWN BY: J.T. CHECKED BY: J.T. PLOT SCALE: 1/16" = 1'-0"	REVIEW: ISSUED FOR PERMIT DATE: 5-7-2019 DRAWN BY: J.T. CHECKED BY: J.T. PLOT SCALE: 1/16" = 1'-0"
--	--	---	--	--	--	---	--

FY19 DEPARTMENT OF HOMELAND SECURITY-CENTRALIZED PROCESSING CENTER-EL PASO, TEXAS  
SOLICITATION NO. W8126519R0097

PROJECT TITLE: MODULAR BUILDING SHOP	SHEET NO. A-801	SHEET 27 OF 29
--------------------------------------	-----------------	----------------

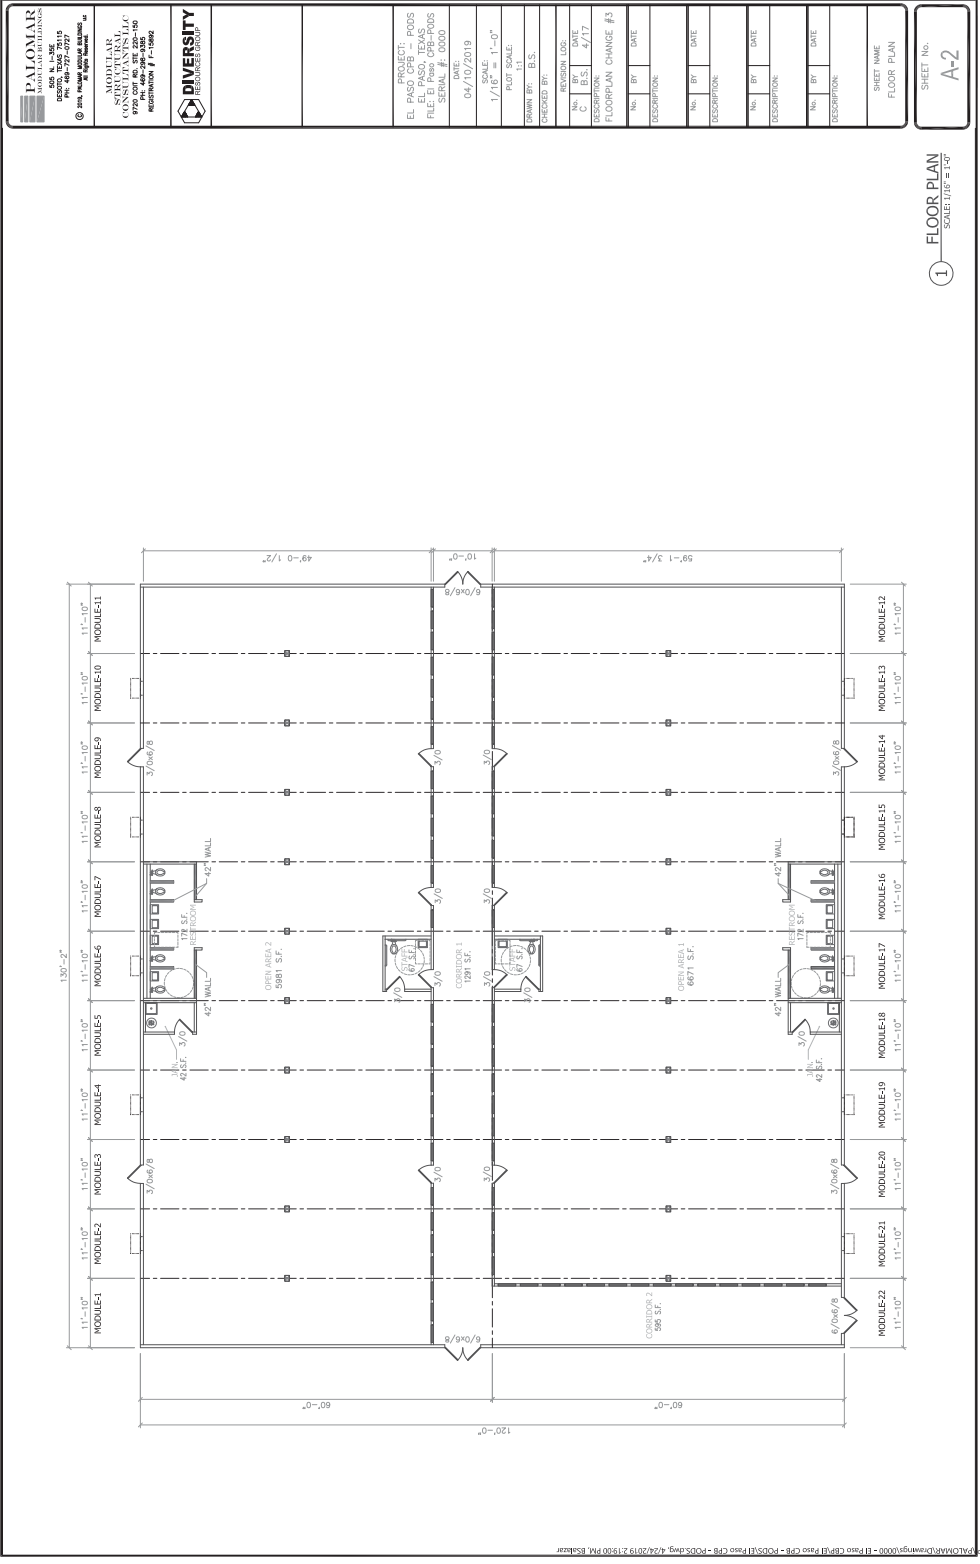

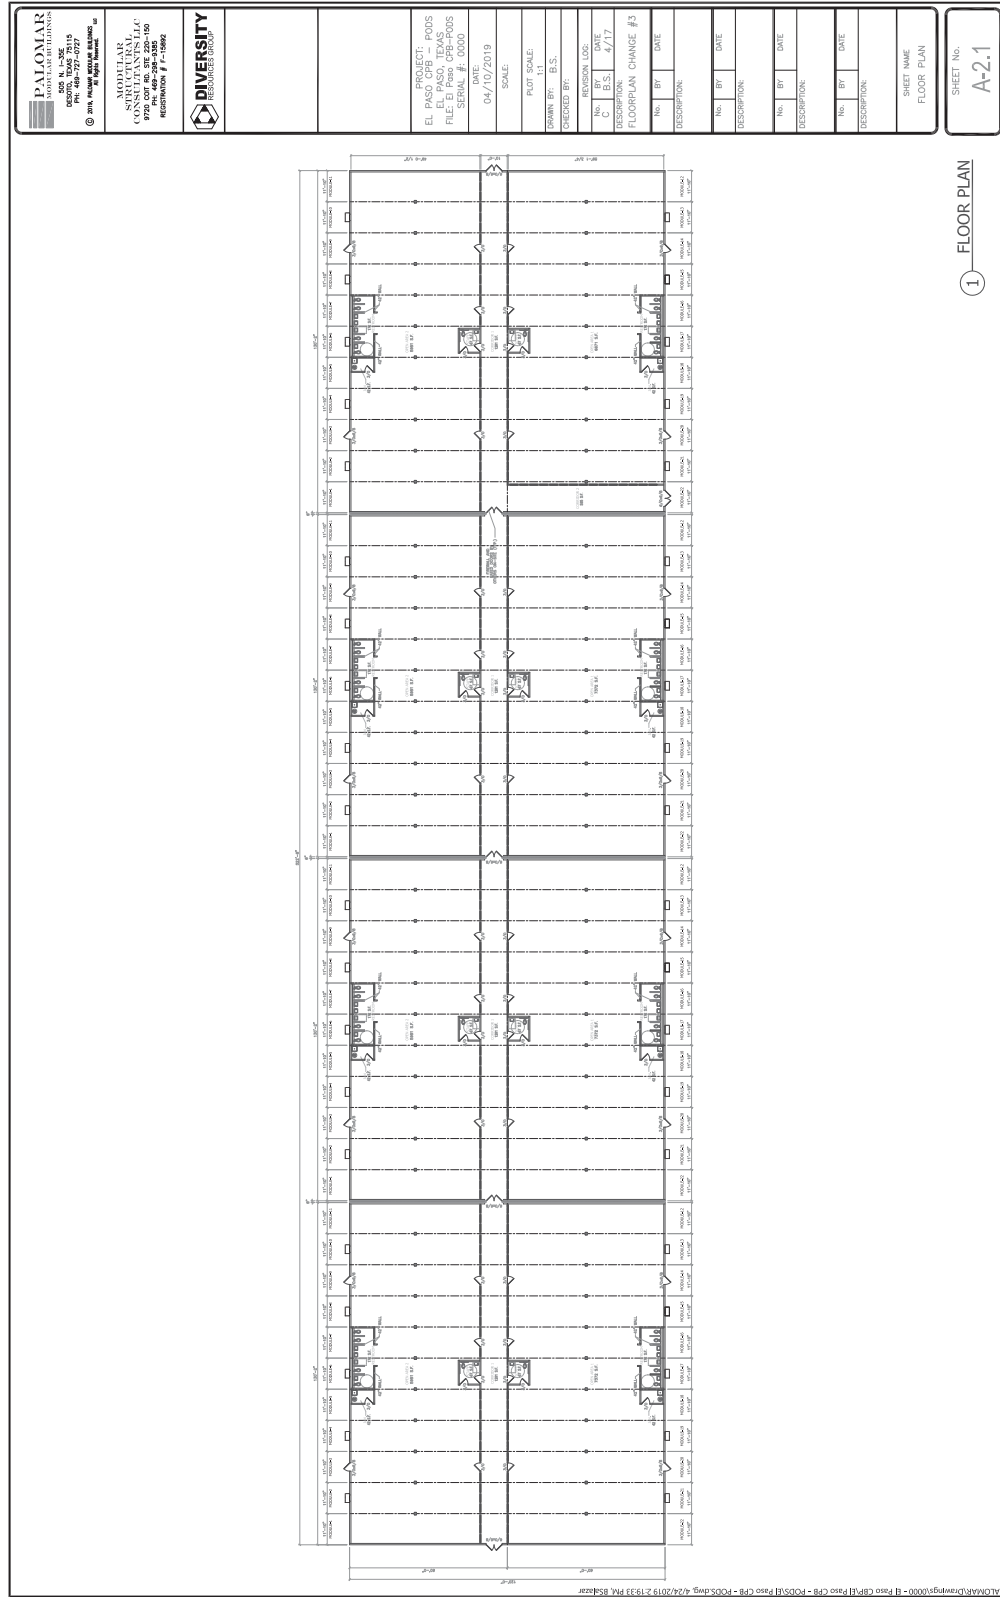

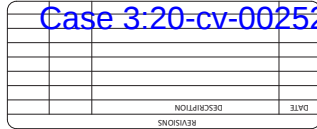

**SHEET TITLE:**  
MODULAR BUILDING SHOP  
DRAWING

**SHEET NO.**  
A-803

FY19 DEPARTMENT OF HOMELAND  
SECURITY-CENTRALIZED PROCESSING  
CENTER-EL PASO, TEXAS  
SOLICITATION NO. W5136C19B00097

**CONSTRUCTION**  
3129 HWY 83 UNIT #7  
SCOTTSDALE, AZ 85267  
OFFICE: 520-732-2803

**PINNACLE**  
DESIGN GROUP, LLC  
ARCHITECTS + PLANNERS  
CONSTRUCTION MANAGERS

DATE:	19	REVIEW:	ISSUED FOR PERMIT	VH	DRAWN BY:
checked by:	5-7-2019	ACCEPTANCE DATE:	5-7-2019	DLF	CHECKED BY:
Post Date: 5/8/2019			Post Scale: REFER TO DRAWING		

